



United States Department of the Interior



BUREAU OF INDIAN AFFAIRS
Great Plains Regional Office
115 Fourth Avenue S.E., Suite 400
Aberdeen, South Dakota 57401

IN REPLY REFER TO:
DESCRM
MC-208

NOV 16 2011

MEMORANDUM

TO: Superintendent, Fort Berthold Agency
FROM: ^{Acting} Regional Director, Great Plains Region
SUBJECT: Supplemental to Environmental Assessment

A handwritten signature in black ink that reads "Tim Johnson".

A Categorical Exclusion has been completed in compliance with the regulations of the National Environmental Policy Act (NEPA) of 1969, as amended. The proposed Supplemental Categorical Exclusion is for information tiering off of an existing Environmental Assessment for QEP Energy and authorizes redefining the diameter of water pipeline. No new surface disturbances will be associated with this proposed action.

All the necessary requirements of the National Environmental Policy Act have been completed. Attached for your files is a copy of the Categorical Exclusion.

If you have any questions, please call Marilyn Bercier, Regional Environmental Scientist, Division of Environment, Safety and Cultural Resources Management, at (605) 226-7656.

Attachment

cc: Tex Hall, Chairman, Three Affiliated Tribes (with attachment)
Elgin Crows Breast, THPO (with attachment)
Derek Enderud, BLM, Dickenson, ND (with attachment)
Jerry Reinisch, QEP Contractor (with attachment)
John Shelman, US Army Corps of Engineers
Jeffrey Hunt, Fort Berthold Agency



United States Department of the Interior

BUREAU OF INDIAN AFFAIRS
Great Plains Regional Office
115 Fourth Avenue S.E.
Aberdeen, South Dakota 57401



IN REPLY REFER TO:
DESCRM
MC-20820

EXCEPTION CHECKLIST FOR BIA CATEGORICAL EXCLUSIONS

Date: 11/9/2011

Project: Supplemental to the Environmental Assessment for QEP Energy Company, MHA Gathering System Supplementing the QEP Energy Company, MHA Gathering System, Development and Construction of Oil, Gas and Water Pipelines and Electrical Utility, March 2010, MHA Gathering System, Development and Construction of Oil, Gas and Water Pipelines and Electrical Utility, CATEX for construction re-routes, September 2010, MHA 2-01-02H-149-91, MHA 2-07-18H-149-91, MHA 1-01-02H-149-91 Exploratory Oil and Gas Wells, August 2010, MHA 1-05-06H-149-91, MHA 3-05-06H-14991, MHA 1-09-06H-149-91, MHA 3-09-16H-149-91, MHA 1-04-03H-149-91 and MHA 3-04-03H-149-91 Exploratory Oil and Gas Wells, March, 2011, MHA 2-05-06H-149-90, MHA 3-05-06H-149-91, MHA 1-11-14H-149-90 and MHA 2-10-15H-149-90 Exploratory Oil and Gas Wells, December 2010 to Authorize the use of three to six inch water pipeline diameter along the MHA Gathering System route.

Nature of Proposed Action: The purpose of the proposed action is to authorize QEP to define the diameter of the water pipeline to be placed along the MHA Gathering Line existing ROW. No new surface disturbances will be associated with the installation of the produced water gathering pipeline.

Exclusion category and number: 516 DM 10.5G(3)

Evaluation of Exceptions to use of Categorical Exclusion:

1. This action would have significant adverse effects on public health or safety. No Yes
2. This action would have an adverse effect on unique geographical features, such as wetlands, wild or scenic rivers, refuges, floodplains, rivers placed on nationwide river inventory, or prime or unique farmlands. No Yes
3. The action will have highly controversial environmental effects. No Yes
4. The action will have highly uncertain environmental effects or involve unique or unknown environmental risks. No Yes
5. This action will establish a precedent for future actions. No Yes
6. This action is related to other actions with individually insignificant, but cumulatively significant environmental effects. No Yes

7. This action will affect properties listed or eligible for listing in the National Register of Historic Places. No X Yes _____
8. This action will affect a species listed, or proposed to be listed as endangered or threatened. No X Yes _____
9. This action threatens to violate federal, state, local or tribal law or requirements imposed for protection of the environment. No X Yes _____
10. This action will have a disproportionately high and adverse effect on low income or minority populations. No X Yes _____
11. This action will limit access to, and ceremonial use of Indian sacred sites on federal lands by Indian religious practitioners, or significantly adversely affect the physical integrity of such sacred sites. No X Yes _____
12. This action will contribute to the introduction, continued existence, or spread of noxious weeds or non-native invasive species known to occur in the area, or may promote the introduction, growth, or expansion of the range of such species. No X Yes _____

A "yes" to any of the above exceptions will require that an EA be prepared.

NEPA Action --- CE X EA _____

Preparer's Name and Title: Jerry D. Reinisch, Biological/Environmental Contractor, Bismarck, ND

Regional Archeologist Concurrence with Item 7

Concur: Marely Delee
Regional Office/Agency Environmental Coordinator

Date: 11/14/11

Concur: Tim LaPointe
Regional Director/Superintendent

Date: 11-16-2011

ENVIRONMENTAL ASSESSMENT

Addendum/Supplemental

United States Bureau of Indian Affairs

Great Plains Regional Office
Aberdeen, South Dakota



Addendum/Supplemental to:

QEP Energy Company's

March 2010 Environmental Assessment: MHA Gathering System Development and Construction of Oil, Gas, Water Pipelines and Electrical Utility

Fort Berthold Indian Reservation

November 2011

For information contact:

*Bureau of Indian Affairs, Great Plains Regional Office
Division of Environment, Safety and Cultural Resources
115 4th Avenue SE
Aberdeen, South Dakota 57401
605-226-7656*

CONTENTS

1	Purpose and Need for the Proposed Action	1
2	Authorities	2
3	Legal Land Description of Proposed Action	3
4	Scope of Work for Proposed Action	3
5	Applicable National Environmental Policy Act (NEPA) Documents	3
6	Cultural Resources.....	4
7	NEPA Adequacy Criteria.....	4

EXHIBITS

Figure 1 ROW Boundaries	1
Figure 2 Project Overview Map	2

1 PURPOSE AND NEED FOR THE PROPOSED ACTION

QEP proposes to authorize the use of three to six inch flex-steel water pipeline to be installed in the existing ROW (Right-of-Way) covered by the previously authorized EA for the March 2010 Environmental Assessment: MHA Gathering System Development and Construction of Oil, Gas, and Water Pipelines and Electrical Utility. A four-inch water line had been previously identified. Trenching equipment would make a one-time pass over the area with minimal disturbance. No other pipeline installation related activities or excavation would impact the ROW. The water pipeline would be initiated in the NE $\frac{1}{4}$ of Section 6, Township 149 North, Range 90 West, and the project would terminate in the SW $\frac{1}{4}$ of Section 4, Township 150 North, Range 90 West. *Please refer to Figure 1, ROW boundaries.*

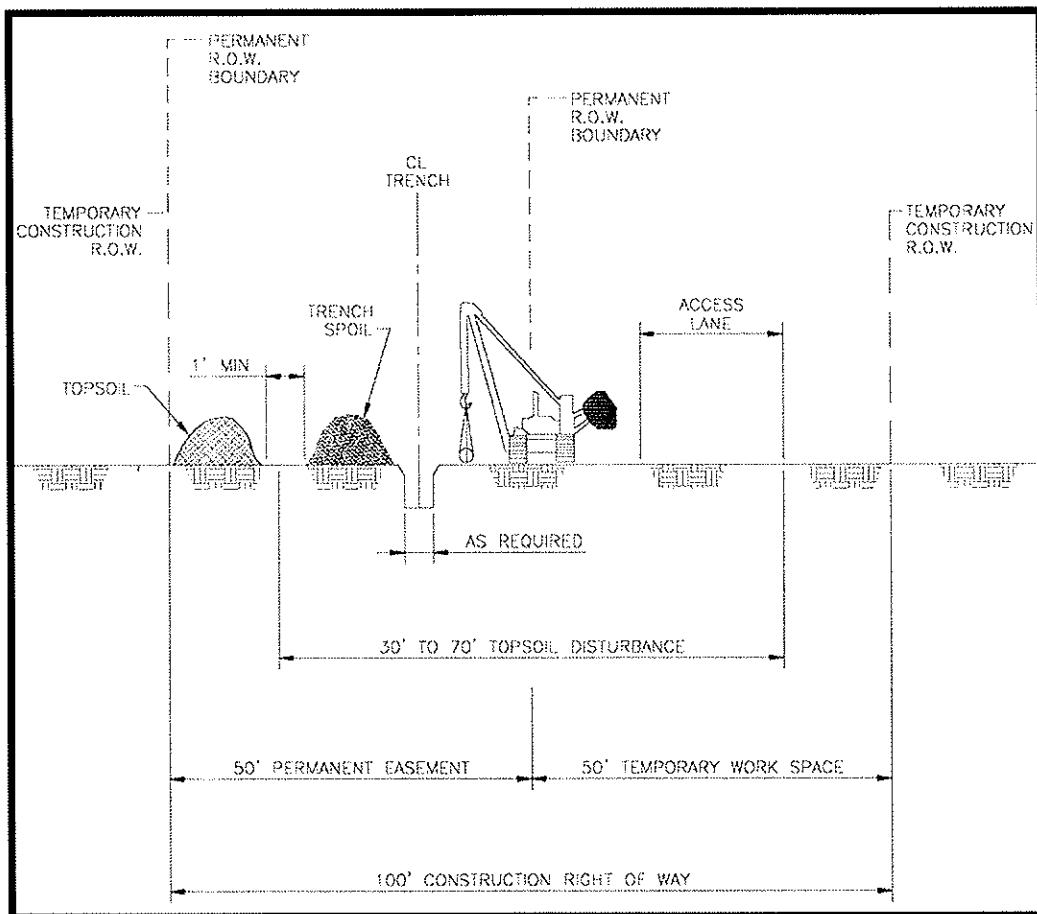


Figure 1, ROW Boundaries

The water pipeline would be installed along the existing corridor using 6-inch flex-steel pipe for the main portion of the line (Yellow). The laterals would be a 4-inch flex-steel pipe (Blue) and the well connects would be a 3-inch (Red) flex-steel pipe. *Please see Figure 2, Project Overview Map.*

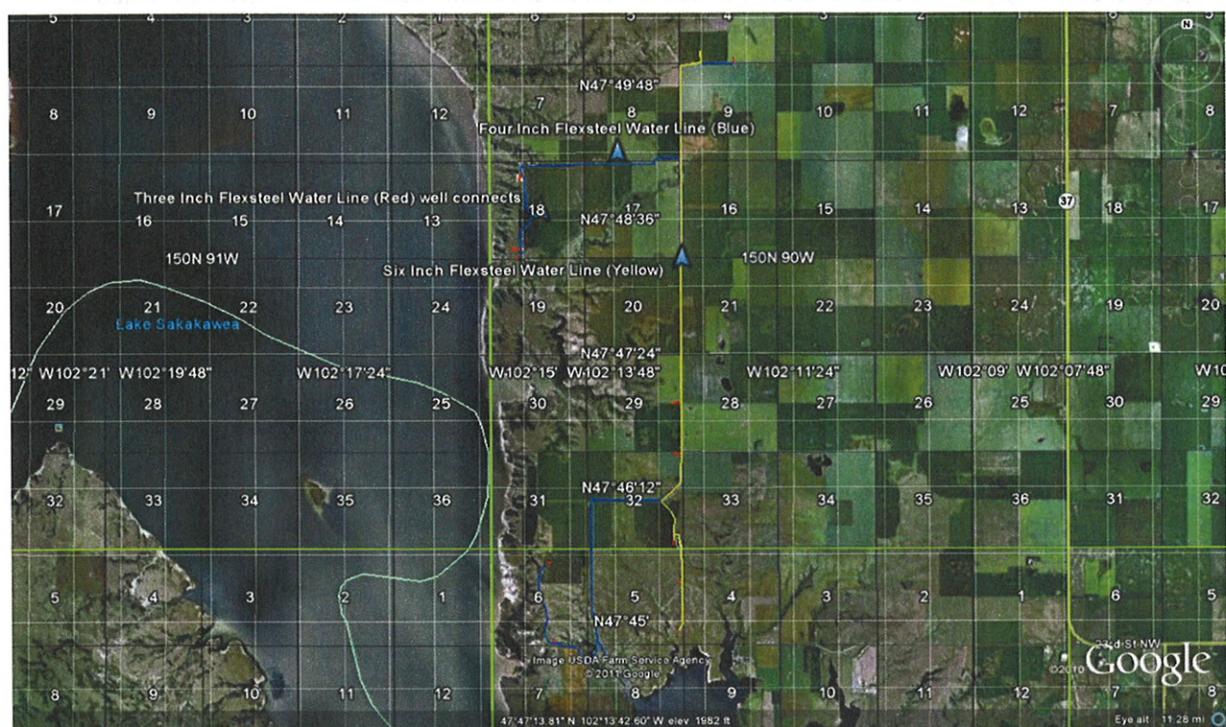


Figure 2, Project Overview Map

The flex-steel pipe for the proposed water line project was purchased directly from the manufacturer as there are no distributors for this product. The 6-inch (Yellow) flex-steel pipe has a 1,500 PSI (pounds per square inch) maximum operating pressure with a 7.083 inch O.D. (outside diameter) and a 5.604 inch I.D. (inside diameter). The 4-inch (Blue) flex-steel pipe used for the water pipeline laterals has a maximum operating pressure 1,000 PSI with a 4.680 inch O.D. and a 3.669 inch I.D. The 3-inch (Red) flex-steel pipe used for the well connects has a maximum operating pressure of 1,000 PSI with a 3.682 inch O.D. and a 2.821 inch I.D. The Construction activities would take place atop areas that have achieved a Finding of No Significant Impact NEPA approval.

2 AUTHORITIES

Oil and gas exploration and development activities are conducted under authority of the Indian Mineral Leasing Act of 1938 (25 United States Code [USC] 396a, et seq.), the Indian Mineral Development Act of 1982 (25 USC 2101, et seq.), and the Energy Policy Act of 2005 (42 USC 15801, et seq.).

3 LEGAL LAND DESCRIPTION OF PROPOSED ACTION

The proposed water pipeline would initiate in the NE% of Section 6, T149N, R90W would be located within the previously authorized pipeline alignment and temporary construction ROW (**Appendix A**). The produced water pipeline would end in the SW% of Section 4, Township 150 North, Range 90 West.

4 SCOPE OF WORK FOR PROPOSED ACTION

The proposed water line pipeline would be constructed within the previously approved ROW and temporary construction ROW. The proposed water pipeline would be buried, using a trenching technique, at a depth of approximately 8-feet. The operating pressure would be approximately 1,000 PSI. The construction and surface disturbance would occur within previously approved locations. These are BIA approved ROWs #100108, #100109, #100240 and #100280. As such, no additional environmental impacts aside from those disclosed in the previously referenced NEPA documents are anticipated from construction of the proposed water pipeline. The As-built data for the existing oil and gas lines along the proposed water line route show the construction within the previously approved ROW (**Appendix A**).

5 APPLICABLE NATIONAL ENVIRONMENTAL POLICY ACT (NEPA) DOCUMENTS

Environmental Assessment: The MHA Gathering System, Development and Construction of Oil, Gas and Water Pipelines and Electrical Utility, March 2010.

Environmental Supplemental: The MHA Gathering System, Development and Construction of Oil, Gas and Water Pipelines and Electrical Utility, CATEX for construction re-routes, September 2010.

Environmental Assessment: The MHA 2-01-02H-149-91, MHA 2-07-18H-149-91, MHA 1-01-02H-149-91 Exploratory Oil and Gas Wells, August 2010.

Environmental Assessment: The MHA 1-05-06H-149-91, MHA 3-05-06H-149-91, MHA 1-09-06H-149-91, MHA 3-09-16H-149-91, MHA 1-04-03H-149-91 and MHA 3-04-03H-149-91 Exploratory Oil and Gas Wells, March, 2011.

Environmental Assessment: The MHA 2-05-06H-149-90, MHA 3-05-06H-149-91, MHA 1-11-14H-149-90 and MHA 2-10-15H-149-90 Exploratory Oil and Gas Wells, December 2010.

6 CULTURAL RESOURCES

The proposed project area has been surveyed for cultural resources as part of the NEPA processes discussed above. There was a finding of *No Historic Properties Affected*.

As all construction activities associated with the proposed definition of water pipeline diameters would utilize areas that have achieved cultural resource clearance, it is anticipated that the proposed project would not impact cultural resources.

7 NEPA ADEQUACY CRITERIA


This document has identified five previously prepared NEPA documents, MHA Gathering System, Development and Construction of Oil, Gas and Water Pipelines and Electrical Utility, March 2010, MHA Gathering System, Development and Construction of Oil, Gas and Water Pipelines and Electrical Utility, CATEX for construction re-routes, September 2010, MHA 2-01-02H-149-91, MHA 2-07-18H-149-91, MHA 1-01-02H-149-91 Exploratory Oil and Gas Wells, August 2010, MHA 1-05-06H-149-91, MHA 3-05-06H-149-91, MHA 1-09-06H-149-91, MHA 3-09-16H-149-91, MHA 1-04-03H-149-91 and MHA 3-04-03H-149-91 Exploratory Oil and Gas Wells, March, 2011, MHA 2-05-06H-149-90, MHA 3-05-06H-149-91, MHA 1-11-14H-149-90 and MHA 2-10-15H-149-90 Exploratory Oil and Gas Wells, December 2010 also included the placement of pipelines and electrical utility in the access road ROW which adequately describes the environmental consequences of the newly proposed actions described herein, and meets the following NEPA Adequacy Criteria:

1. The proposed actions are substantially the same actions and at the sites specifically analyzed in the existing NEPA documents.
2. The range of alternatives is reasonable with respect to the current proposed actions in the existing NEPA documents, which appropriately considers and analyzes current environmental concerns, interests, and resource values.
3. The existing analysis and conclusions are adequate in the existing NEPA documents. The analysis is still valid in light of new studies and/or resource assessment information.
4. The methodology and analytical approach used in the existing NEPA documents continues to be appropriate for the proposed actions.
5. The direct and indirect impacts of the proposed actions are unchanged from those identified in the existing NEPA documents.
6. The cumulative impacts that would result from implementation of the proposed actions are unchanged from those analyzed in the existing NEPA documents.
7. A 30-day comment period involving public input and interagency review was used in the development of the existing NEPA documents.

Appendix A

WILLISTON GATHERING SYSTEM WATER LINE

QEP FIELD SERVICES

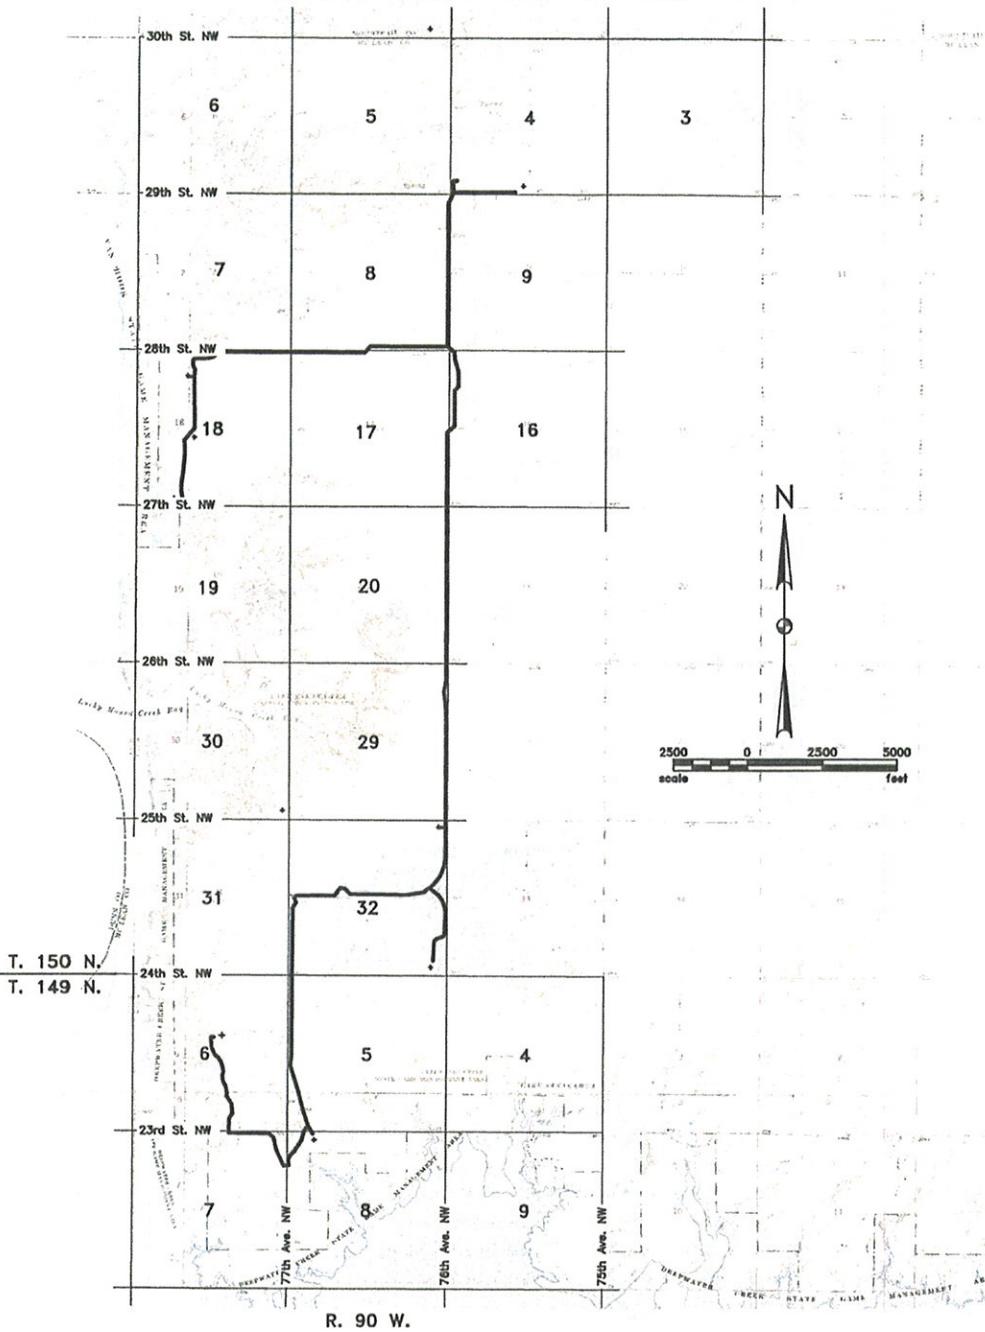

T. 149 N., R. 90 W.

SECTION 5
SHEETS 6 & 8

SECTION 6
SHEETS 1 & 2

SECTION 7
SHEETS 3 & 4

SECTION 8
SHEETS 5 & 7

T. 150 N., R. 90 W.

SECTION 4
SHEET 27

SECTION 8
SHEETS 22, 26, 33 & 34

SECTION 9
SHEETS 23, 24 & 25

SECTION 16
SHEETS 20 & 21

SECTION 17
SHEETS 19 & 32

SECTION 18
SHEETS 30 & 31

SECTION 20
SHEETS 17 & 18

SECTION 29
SHEETS 15 & 16

SECTION 32
SHEETS 9, 10, 11, 12, 13, 14,
28 & 29



QEP Energy Company
1050 17th Street, Suite 500
Denver, CO 80265-1050

NOTE:
Survey is based on North Dakota State Plane System, NAD83 (96), North Zone, U.S. Foot. Azimuths shown are Grid Azimuths, distances shown are grid distance. Combined scale factor = 1.0001430 to go from grid distance to ground distance.


**Kadomas
Lee &
Jackson**
Engineers Surveyors
Planners

Drawn By: S. Wolf Date: 10/17/2011

© Kadomas, Lee & Jackson 2011

ALLOTTED TRACT 2221

S1/2NE1/4 OF SECTION 6, TOWNSHIP 149 NORTH, RANGE 90 WEST
OF THE 5TH PRINCIPAL MERIDIAN, MCLEAN COUNTY, NORTH DAKOTA
EXHIBIT "A"

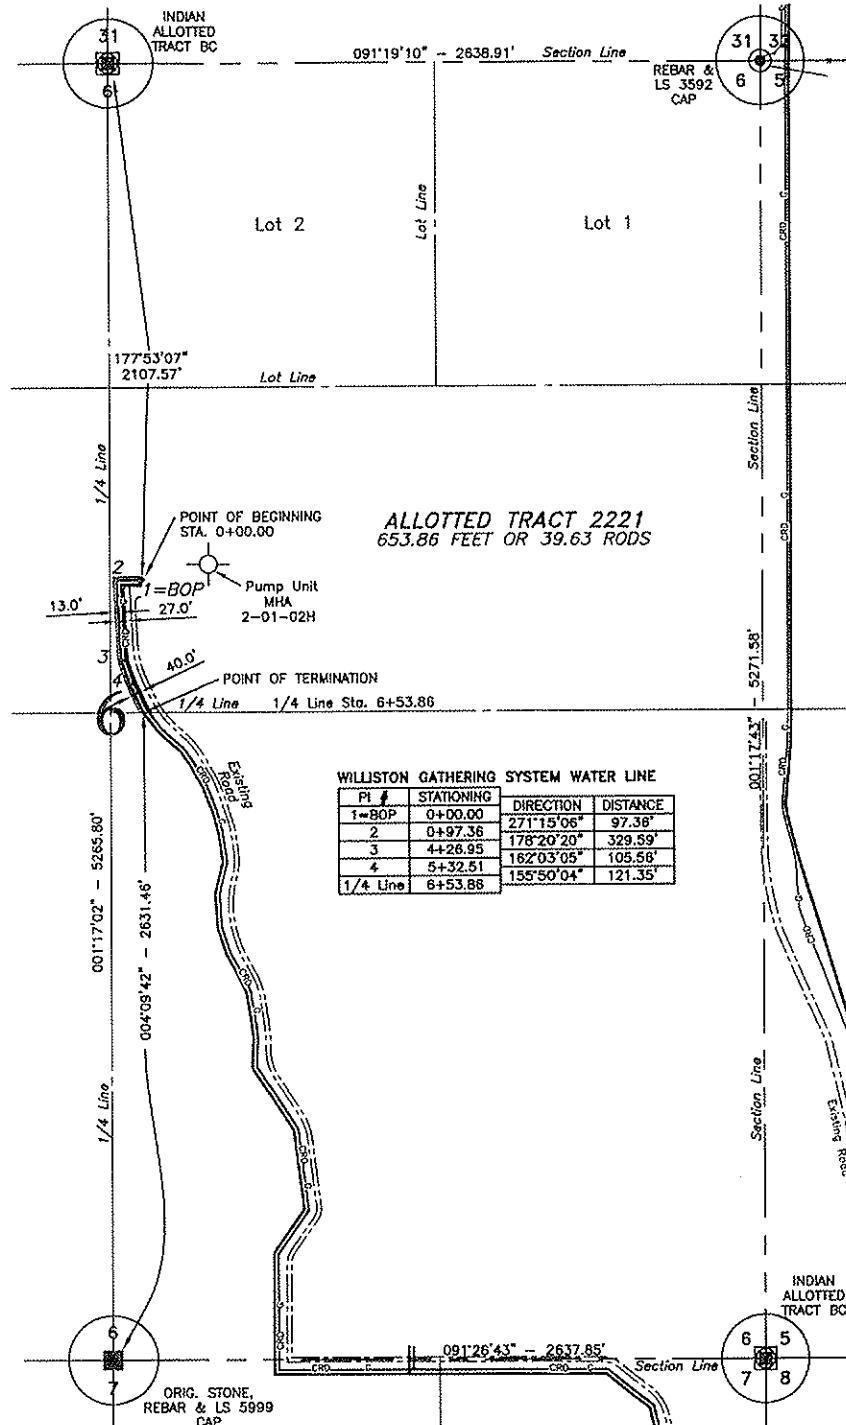

NOTE:
Survey is based on North Dakota State Plane System, NADB3 (98), North Zone, U.S. Foot.
Azimuths shown are Grid Azimuths, distances shown are grid distance. Combined scale factor = 1.0001430 to go from grid distance to ground distance.

300 0 300 600
scale 1"=600' feet

SHEET 1 OF 34

Kadomas
Lee &
Jackson
Engineers Surveyors
Planners



1050 17th Street,
Suite 500
Denver, CO
80265-1050

QEP FIELD SERVICES

WILLISTON GATHERING SYSTEM WATER LINE

PROPOSED PIPELINE LOCATION ON AND ACROSS THE
S1/2NE1/4 OF SEC. 6, T.149N., R.90W.

DWG NO.
3709480BAS05

JOB NO.
3709480

SCALE: 1"=600'
TRACT NUMBER

6-149-90-A


DRAWN BY S. WHIT

CREATED DATE: 10/17/2011

REV. DATE:

ALLOTTED TRACT 24

SE1/4 OF SECTION 6, TOWNSHIP 149 NORTH, RANGE 90 WEST
OF THE 5TH PRINCIPAL MERIDIAN, MCLEAN COUNTY, NORTH DAKOTA
EXHIBIT "A"

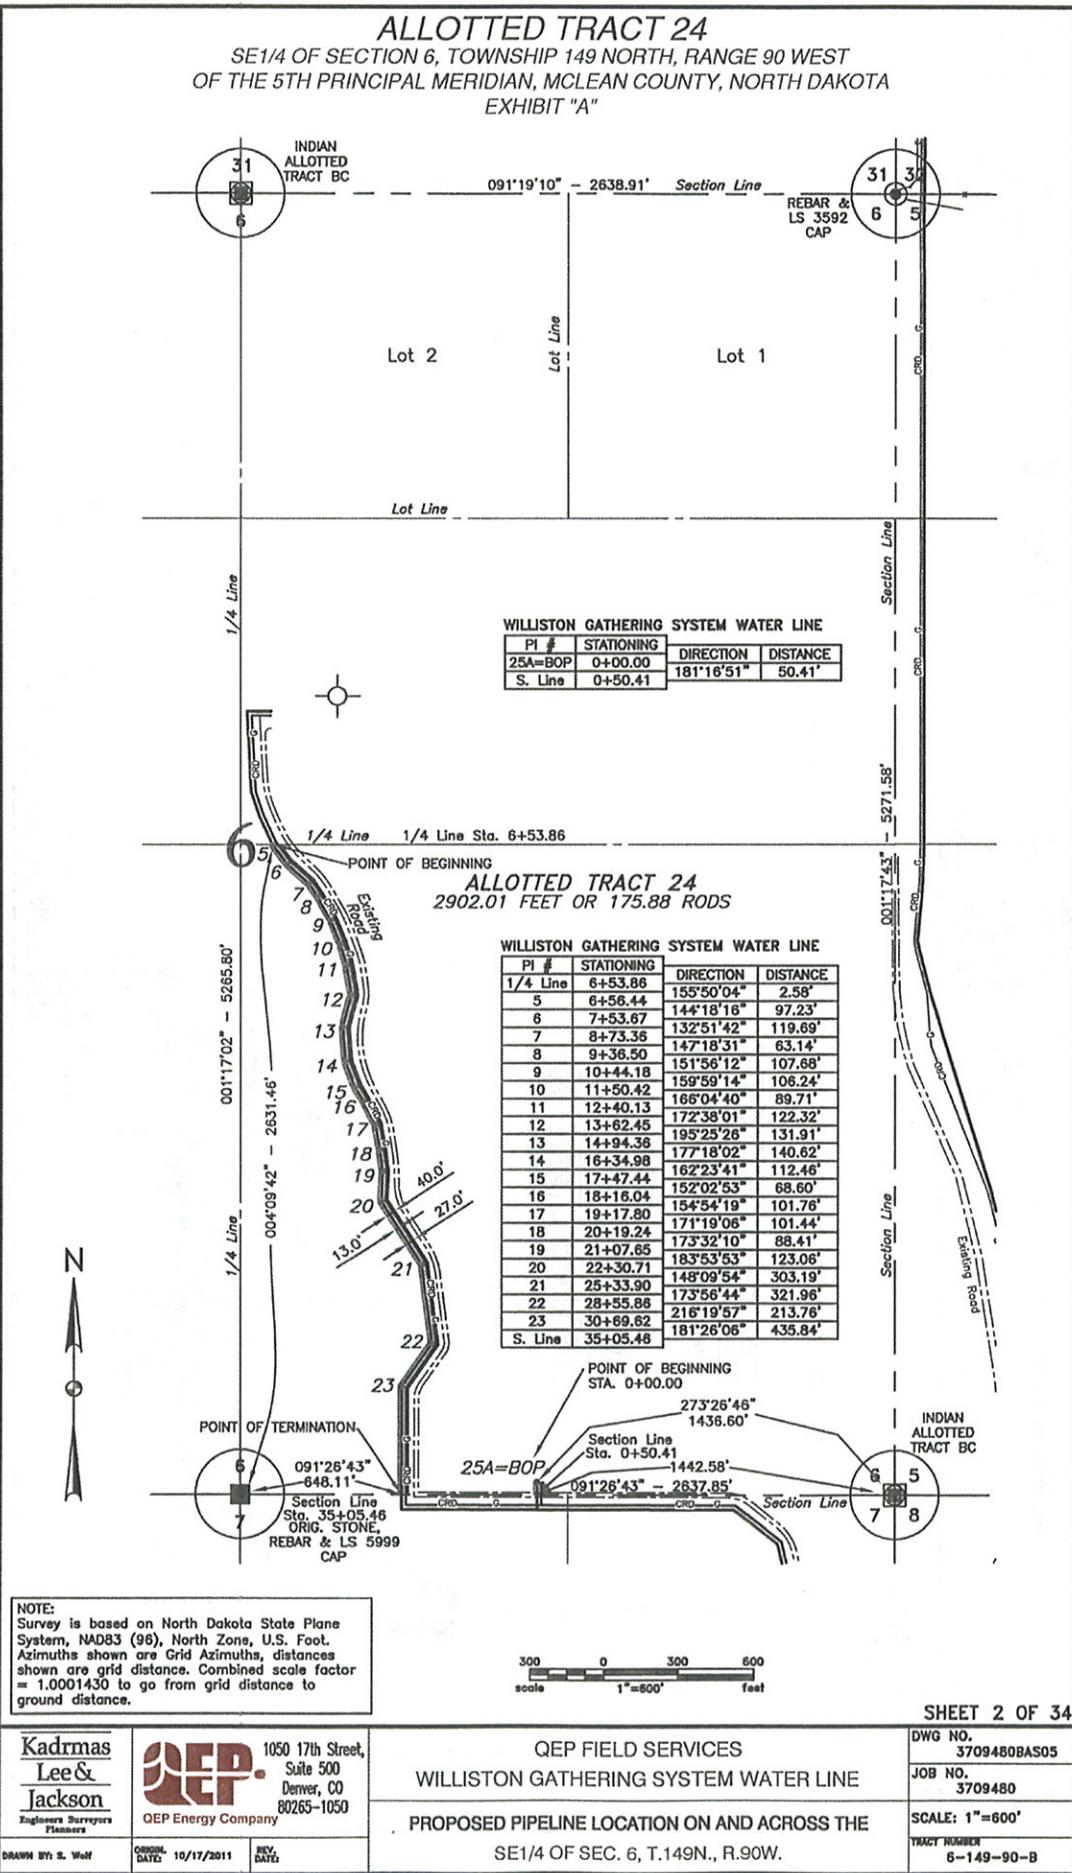

ALLOTTED TRACT 313

W1/2NE1/4 OF SECTION 7, TOWNSHIP 149 NORTH, RANGE 90 WEST
OF THE 5TH PRINCIPAL MERIDIAN, MCLEAN COUNTY, NORTH DAKOTA

EXHIBIT "A"

INDIAN
TRACT BC



Lot 1

Lot Line

Lot 2

Section Line

Lot Line

1/4 Line

1/16 Line

ALLOTTED TRACT 313
790.99 FEET OR 47.94 RODS

POINT OF BEGINNING
648.11' S. 35+55.46' E.
ORIG. & LS 5999
REBAR & LS 5999
CAP

POINT OF TERMINATION
40.0' EOP
13.0' 25.26' 26.37' 55'
Sta. 42+38.47' 442.56'
Sta. 42+38.47' 442.56'

Existing
Road

Section Line

N

WILLISTON GATHERING SYSTEM WATER LINE			
PI #	STATIONING	DIRECTION	DISTANCE
S. Line	35+05.46	181°26.06'	59.98'
24	35+65.44	091°26.43'	54.732'
25	41+12.76	091°26.43'	59.83'
26	41+72.59	091°26.43'	63.88'
1/16 Line	42+38.47'		

WILLISTON GATHERING SYSTEM WATER LINE			
PI #	STATIONING	DIRECTION	DISTANCE
S. Line	09+50.41	181°16.51'	59.98'
25=ECOP	1+10.39		


1/4 Line

001'17'22" - 5279.24' (Calc.)

NOTE:
Survey is based on North Dakota State Plane
System, NAD83 (36), North Zone, U.S. Feet.
Azimuths shown are Grid Azimuths, distances
shown are grid distance. Combined scale factor
= 1.00014530 to go from grid distance to
ground distance.



CALCULATED

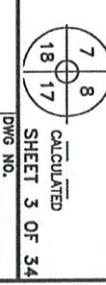

CALCULATED

QEP FIELD SERVICES

1050 17th Street,
Suite 500
Denver, CO
80265-1050

WILLISTON GATHERING SYSTEM WATER LINE
PROPOSED PIPELINE LOCATION ON AND ACROSS THE
W1/2NE1/4 OF SEC. 7, T.149N., R.90W.

scale
1" = 650'

Kadmas	Lee & Jackson
Lee & Jackson	QEP Energy Company
Indusress Surveyors	Planners
DKM&LJ, Inc.	QEP Energy Company

DKM&LJ, Inc.
QEP Energy Company

DATE: 10/17/2011
DWG. NO.: 3705460BAS05
JOB NO.: 3705460
SCALE: 1" = 650'
TRACT NUMBER:
7-149-90-A

DATE: 10/17/2011
DWG. NO.: 3705460BAS05
JOB NO.: 3705460
SCALE: 1" = 650'
TRACT NUMBER:
7-149-90-A

THREE AFFILIATED TRIBES

E1/2NE1/4 OF SECTION 7, TOWNSHIP 149 NORTH, RANGE 90 WEST
OF THE 5TH PRINCIPAL MERIDIAN, MCLEAN COUNTY, NORTH DAKOTA

EXHIBIT "A"

INDIAN
ALLOTTED
TRACT BC



Lot 1

Lot 2

Section Line

Lot Line

1/4 Line

1/16 Line

1/16 Line Sta. 42+36.47



POINT OF TERMINATION

30

ALLOTTED TRACT T32
2041.80 FEET OR 123.75 RODS

WILLISTON GATHERING SYSTEM WATER LINE

PI # STATIONING DIRECTION DISTANCE

PI #	STATIONING	DIRECTION	DISTANCE
1/16 Line	42+36.47	091°26'43"	670.12'
27	49+06.59	128°53'39"	223.18'
28	51+29.77	165°15'50"	421.98'
29	55+51.88	155°44'53"	609.21'
30	61+60.87	084°29'29"	117.40'
S. Line	62+48.27		

1/4 Line

001°17'22" - 5279.24' (Calc.)

Section Line Sta. 62+78.27

Section Line

Section Line

NOTE:
Survey is based on North Dakota State Plane
System, NAD83 (98), North Zone, U.S. Feet.
Azimuths shown are Grid Azimuths, distances
shown are grid distance. Combined scale factor
= 1.0001430 to go from grid distance to
ground distance.



SHEET 4 OF 34
DWG NO. 370948BAS05
JOB NO. 3709480
SCALE: 1"=600'
TRACT NUMBER 7-149-90-B


Kadomas	1050 17th Street, Suite 500
Lee & Jackson	Demer, CO 80265-1050
Engelhart Surveyors Planners	OEP Energy Company
DAKOTA BTL. S. WEL	OPNNG: 10/17/2011 EXP: 06/30/2012

OEP FIELD SERVICES
WILLISTON GATHERING SYSTEM WATER LINE
PROPOSED PIPELINE LOCATION ON AND ACROSS THE
E1/2NE1/4 OF SEC. 7, T.149N., R.90W.

THREE AFFILIATED TRIBES

W1/2W1/2NW1/4 OF SECTION 8, TOWNSHIP 149 NORTH, RANGE 90 WEST
OF THE 5TH PRINCIPAL MERIDIAN, MCLEAN COUNTY, NORTH DAKOTA



EXHIBIT "A"

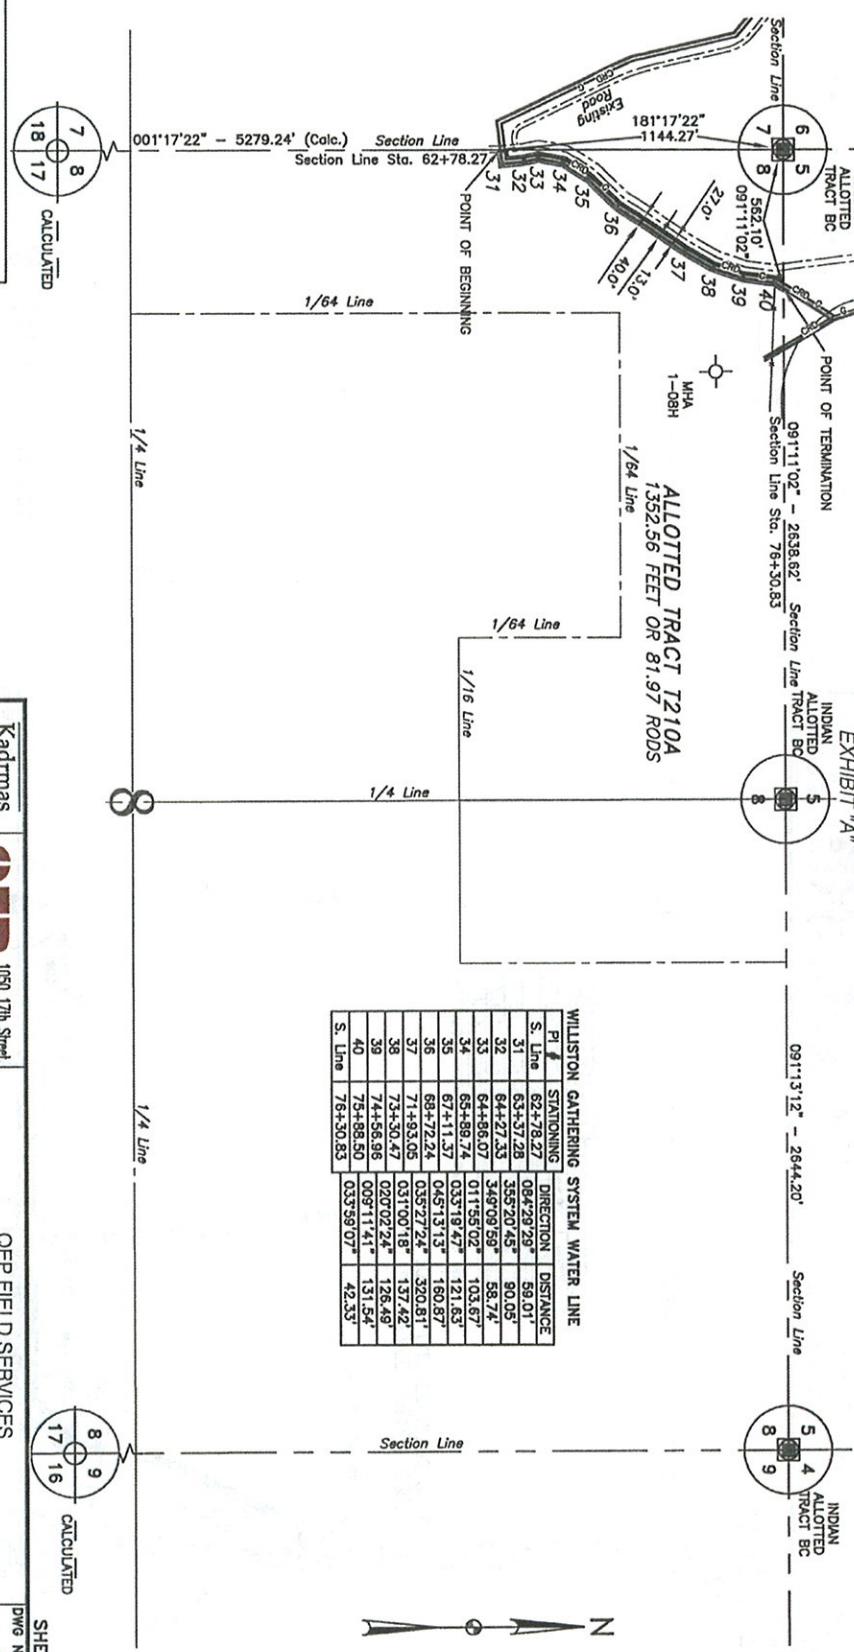

NOTE:

is based on North Dakota State Plane Survey, NAD83 (95), North Zone, U.S. Feet. Azimuths shown are Grid Azimuths; distances shown are grid distance. Combined scale factor = 1.0001330 to go from grid distance to ground distance.

SHEET 5 OF 34

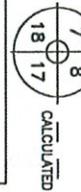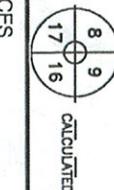


Kadomas	1050 17th Street, Suite 500
Lee &	Denver, CO
Jackson	80205-050
Northern Plains Pipeline	OEP Energy Company

QEP FIELD SERVICES
WILLISTON GATHERING SYSTEM WATER LINE
PROPOSED PIPELINE LOCATION ON AND ACROSS THE
W1/2W1/2NW1/4 OF SEC. 8, T. 149N., R. 90W.

DAWN M. S. W.M.	DATE: 10/17/2011	SCALE: 1=600'
		TRACT NUMBER B-149-90-A

ALLOTTED TRACT 306A

SW1/4SW1/4 OF SECTION 5, TOWNSHIP 149 NORTH, RANGE 90 WEST
OF THE 5TH PRINCIPAL MERIDIAN, MCLEAN COUNTY, NORTH DAKOTA
EXHIBIT "A"

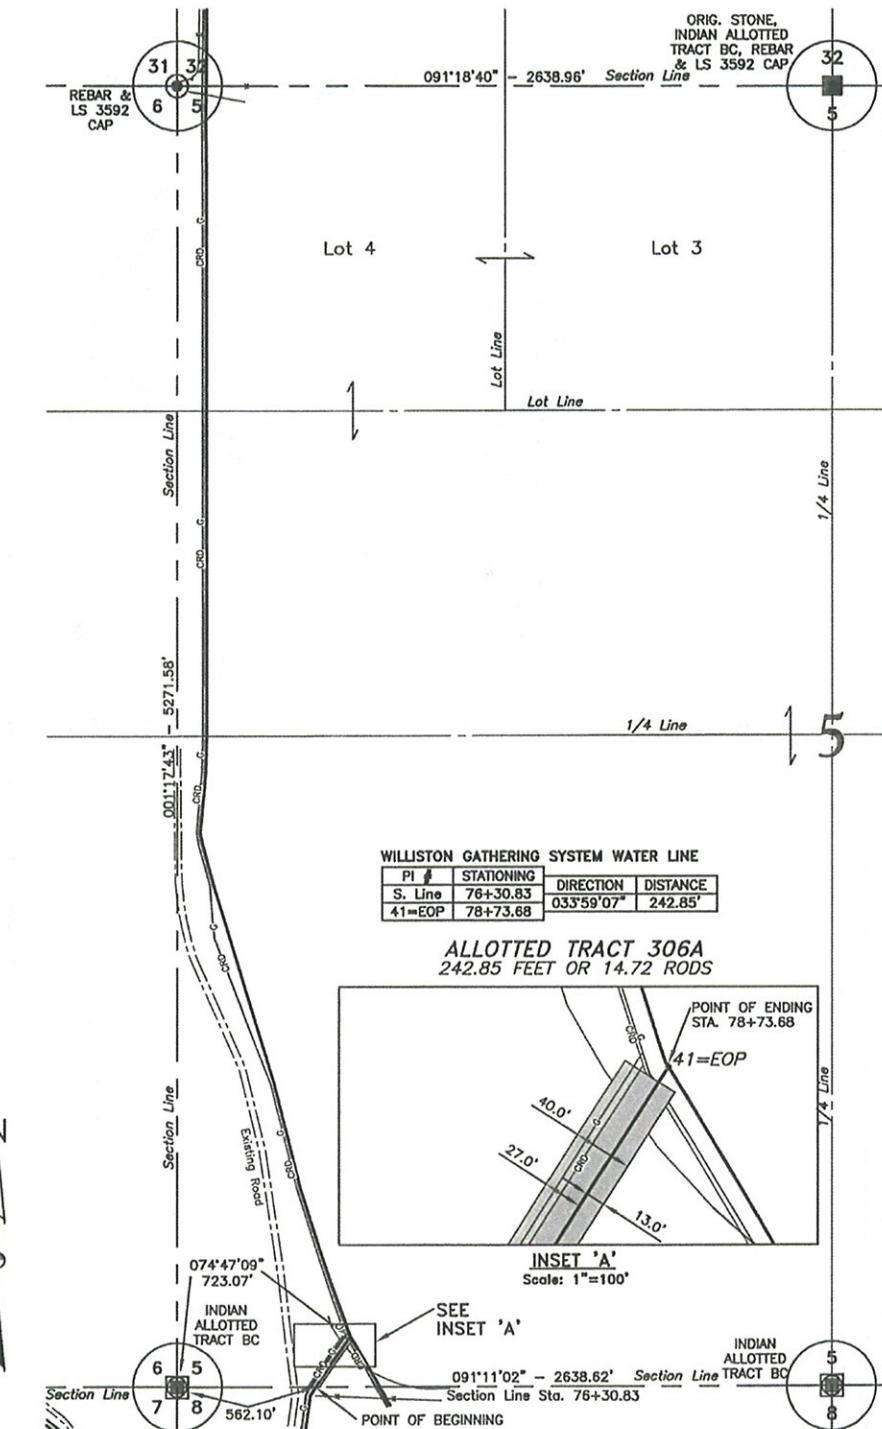

NOTE:
Survey is based on North Dakota State Plane System, NAD83 (96), North Zone, U.S. Foot. Azimuths shown are Grid Azimuths, distances shown are grid distance. Combined scale factor = 1.0001430 to go from grid distance to ground distance.

300 0 300 500
scale 1"=500' feet

SHEET 6 OF 34

Kadrmas
Lee &
Jackson
Engineers Surveyors
Planners



1050 17th Street,
Suite 500
Denver, CO
80265-1050

QEP FIELD SERVICES

WILLISTON GATHERING SYSTEM WATER LINE

PROPOSED PIPELINE LOCATION ON AND ACROSS THE
SW1/4SW1/4 OF SEC. 5, T.149N., R.90W.

DWG NO.
3709480BAS05

JOB NO.
3709480


SCALE: 1"=600'

TRACT NUMBER
5-149-90-A

THREE AFFILIATED TRIBES

N1/2N1/2NW1/4 OF SECTION 8, TOWNSHIP 149 NORTH, RANGE 90 WEST
OF THE 5TH PRINCIPAL MERIDIAN, MCLEAN COUNTY, NORTH DAKOTA

EXHIBIT "A"

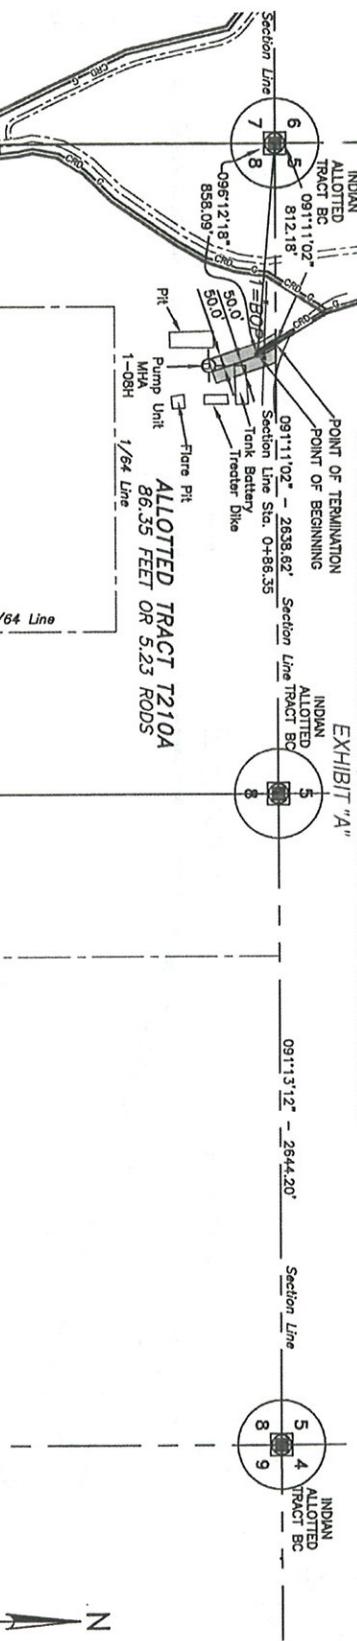

1/4 Line

1/16 Line

1/8 Line

1/16 Line

NOTE:
Survey is based on North Dakota State Plane
System, NAD83 (98), North Zone, U.S. Foot.
Azimuths shown are Grid Azimuths, distances
shown are grid distance. Combined scale factor
= 1.0001430 to go from grid distance to
ground distance.

001°17'22" - 5279.24' (Calc.) Section Line

1/64 Line

1/4 Line

INDIAN
ALLOTTED
TRACT BC
091°11'02"
812.18'

POINT OF BEGINNING
091°11'02" - 2638.62' Section Line
Sect. Line Sta. 0+86.35

INDIAN
ALLOTTED
TRACT BC
091°11'02"
812.18'

INDIAN
ALLOTTED
TRACT BC
091°11'02"
812.18'

7
8
18
17
CALCULATED

WILLISTON GATHERING SYSTEM WATER LINE
PI STATIONING
1-BOP 0-00.00
1-08H 331-3851° 86.35
S. Line 0-086.35
1/64 Line

1/4 Line

7
8
18
17
CALCULATED


8
9
17
16
CALCULATED

SHEET 7 OF 34
Dwg No.
3709480BASOS
Job No.
3709480
OEP Energy Company
PROPOSED PIPELINE LOCATION ON AND ACROSS THE
N1/2N1/2NW1/4 OF SEC. 8, T.149N., R.90W.
SCALE: 1=500'
TRACT NUMBER
8-149-90-A

Kadrimas Lee & Jackson Ruston Surveyors Planners Drew B. Wey	OEP FIELD SERVICES 1050 17th Street, Suite 500 Denver, CO 80225-1050 OEP Energy Company PROPOSED PIPELINE LOCATION ON AND ACROSS THE N1/2N1/2NW1/4 OF SEC. 8, T.149N., R.90W. SCALE: 1=500' TRACT NUMBER 8-149-90-A
---	---

ALLOTTED TRACT 306A

W1/2 OF SECTION 5, TOWNSHIP 149 NORTH, RANGE 90 WEST
OF THE 5TH PRINCIPAL MERIDIAN, MCLEAN COUNTY, NORTH DAKOTA
EXHIBIT "A"

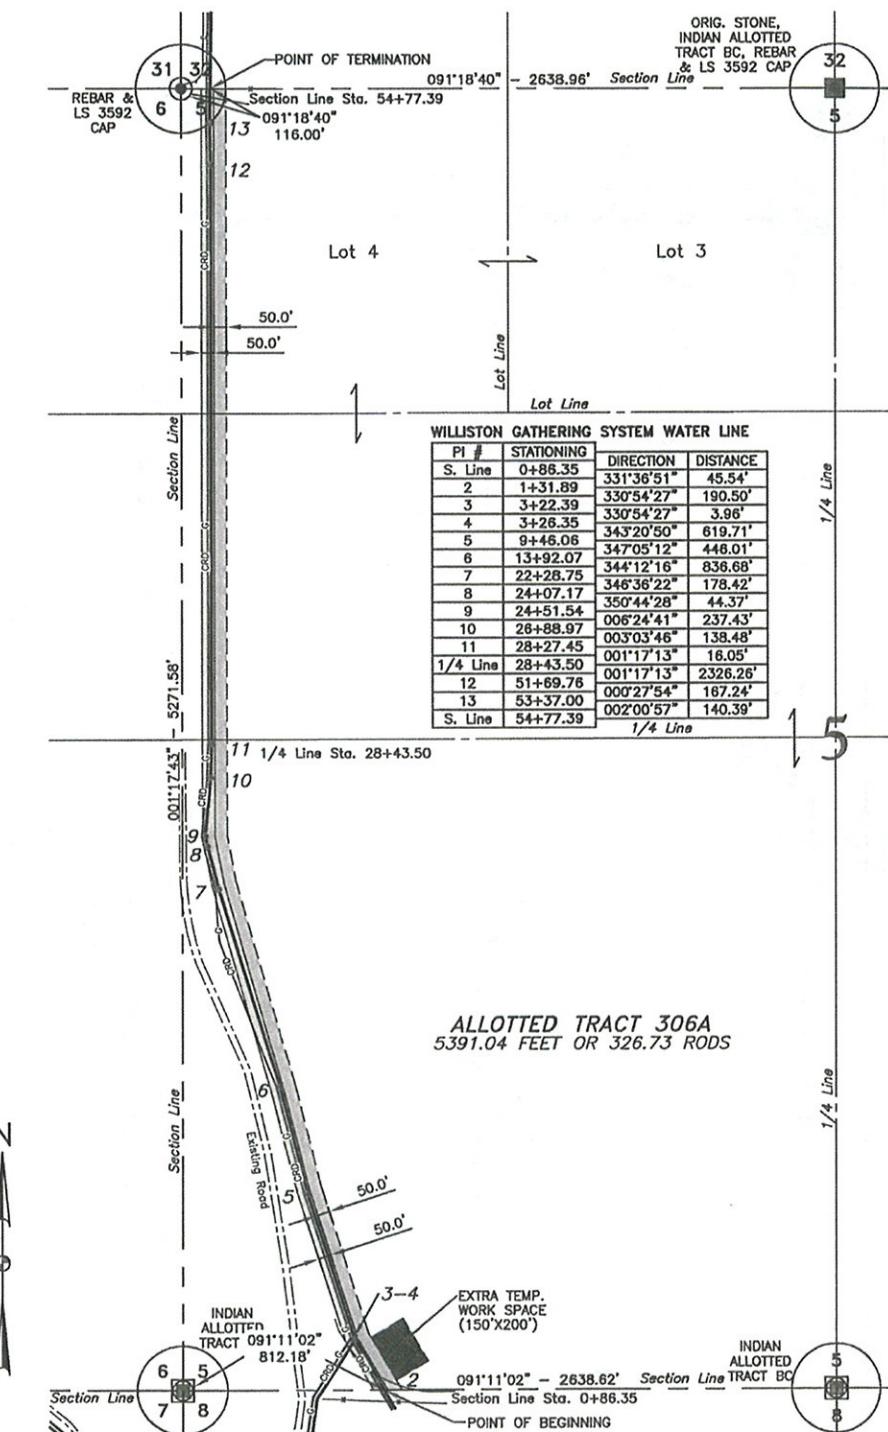

SHEET 8 OF 34

Kadrmas
Lee &
Jackson
Engineers Surveyors
Planners



1050 17th Street,
Suite 500
Denver, CO
80265-1050

QEP FIELD SERVICES
WILLISTON GATHERING SYSTEM WATER LINE
PROPOSED PIPELINE LOCATION ON AND ACROSS THE
W1/2 OF SEC. 5, T.149N., R.90W.

DWG NO.
3709480BAS05

JOB NO.
3709480

SCALE: 1"=600'
TRACT NUMBER
5-149-90-A

DRAWN BY S. Wolf


ORIGINAL DATE 10/17/2011

REV. DATE

THREE AFFILIATED TRIBES


SW1/4SW1/4 OF SECTION 32, TOWNSHIP 150 NORTH, RANGE 90 WEST
OF THE 5TH PRINCIPAL MERIDIAN, MCLEAN COUNTY, NORTH DAKOTA

EXHIBIT "A"

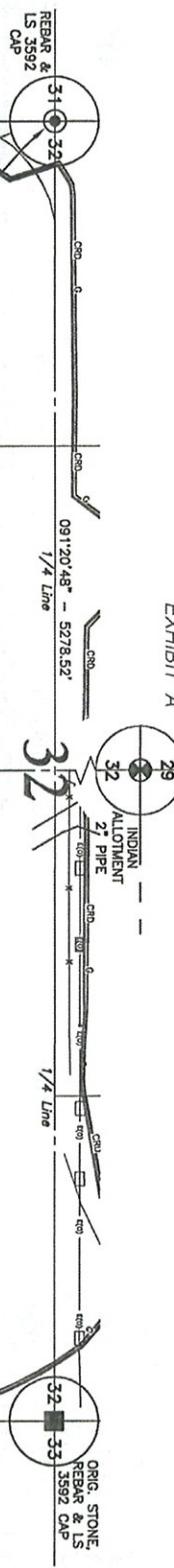

WILLISTON GATHERING SYSTEM WATER LINE

PL #	STATIONING	DIRECTION	DISTANCE
S. Line	54-77.39	002°00'57"	926.91'
1/4	64-04.30	002°00'57"	926.91'
1/16 Line	67-97.27	000°51'43"	392.97'

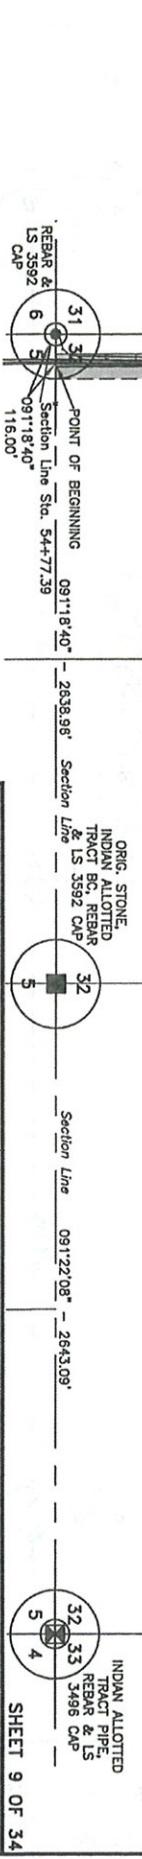

ALLOTTED TRACT T3504-C

1319.88 FEET OR 79.99 RODS

NOTE:
Survey is based on North Dakota State Plane
System, NAD83 (96), North Zone, U.S. Foot.
Azimuths shown are Grid Azimuths, distances
shown are grid distance. Combined scale factor
= 1.0001430 to go from grid distance to
ground distance.

OCT 17, 2011 - 5:43pm - d:\offices\l\Questar\3709480\CAD\PFP\3709480ba05.DWG

© Kofman, Lee & Johnson 2011


LAYOUT: SW-3-150-90-F

Kadmus	1050 17th Street, Suite 500 Denver, CO 80225-1050	OEP FIELD SERVICES
Lee & Jackson	OEP Energy Company Planners	WILLISTON GATHERING SYSTEM WATER LINE
PROPOSED PIPELINE LOCATION ON AND ACROSS THE		SW1/4SW1/4 OF SEC. 32, T.150N., R.90W.
DAWN M. Wolf	ORIGIN. DATE: 10/17/2011 REV. DATE:	SCALE: 1"=500' TRACT NUMBER: 32-150-90-F

THREE AFFILIATED TRIBES

NW1/4SW1/4 OF SECTION 32, TOWNSHIP 150 NORTH, RANGE 90 WEST
OF THE 5TH PRINCIPAL MERIDIAN, MCLEAN COUNTY, NORTH DAKOTA

EXHIBIT "A"

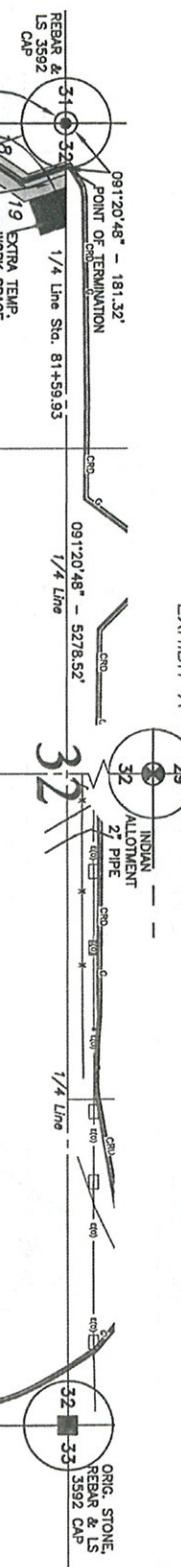

ALLOTTED TRACT T3604-B
7362.66 FEET OR 82.59 RODS
15 POINT OF BEGINNING
1/16 Line Sta. 67+497.27

001°15'21" - 2639.68' 1325.96'


1/16 Line
50.0'

1/16 Line Sta. 67+497.27

PI #	STATIONING	DIRECTION	DISTANCE
1/16 Line	67+497.27	000°51'43"	150.50'
15	69+47.77	000°51'43"	150.50'
16	77+02.81	001°19'04"	755.04'
17	77+84.81	03°38'54"	62.00'
18	78+18.92	54.11'	
19	79+70.66	03°52'22"	151.74'
	34357.21"		189.27'
			1/4 Line 81+59.93

001°10'44" - 2639.07'

001°12'22" - 2643.09'

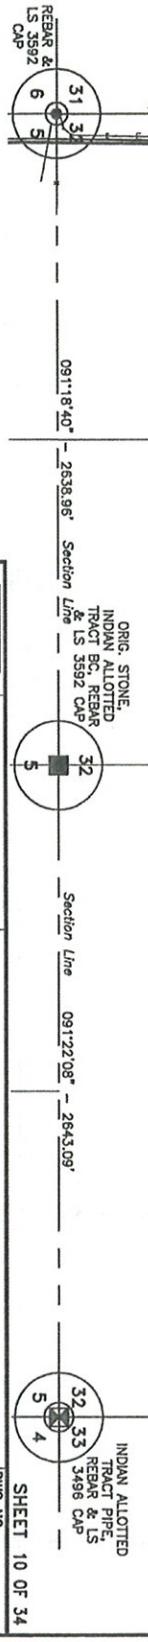

NOTE:
Survey is based on North Dakota State Plane
System, NAD83 (96), North Zone, U.S. Feet.
Azimuths shown are Grid Azimuths, distances
shorter grid distance. Combined scale factor
= 1.0001430 to go from grid distance to
ground distance.

Kadomas	1050 17th Street,
Lee &	Suite 500
Jackson	Denver, CO
青海省	80265-1050
Plains	OEP Energy Company
Damon M. S. Wolf	DATE 10/17/2011 DRAFT DATE

QEP FIELD SERVICES
WILLISTON GATHERING SYSTEM WATER LINE
PROPOSED PIPELINE LOCATION ON AND ACROSS THE
NW1/4SW1/4 OF SEC. 32, T.150N., R.90W.

SCALE: 1"=500'
TRACT NUMBER:
32-150-90-G

LAYOUT: NWISW 10-150-90-0

THREE AFFILIATED TRIBES


W1/2NW1/4 OF SECTION 32, TOWNSHIP 150 NORTH, RANGE 90 WEST
OF THE 5TH PRINCIPAL MERIDIAN, MCLEAN COUNTY, NORTH DAKOTA

EXHIBIT "A"




ALLOTTED TRACT T3564-A 1160.64 FEET OR 70.89 RODS

SEE
INSET 'B'

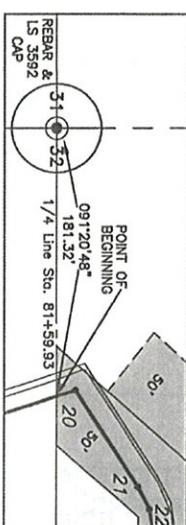

INSET 'B'
Scale: 1"=100'

WILLISTON GATHERING SYSTEM WATER LINE			
PI #	STATIONING	DIRECTION	DISTANCE
1/4 Line	81+59.93	343°07'21"	13.58'
20	81+73.51	343°07'21"	77.78'
21	82+51.28	058°58'40"	17.18'
22	82+68.47	064°00'44"	39.83'
23	83+08.30	063°03'27"	090'48.02"
24	91+23.92	091°48'02"	815.62'
1/16 Line	93+29.57	091°54'57"	205.65'

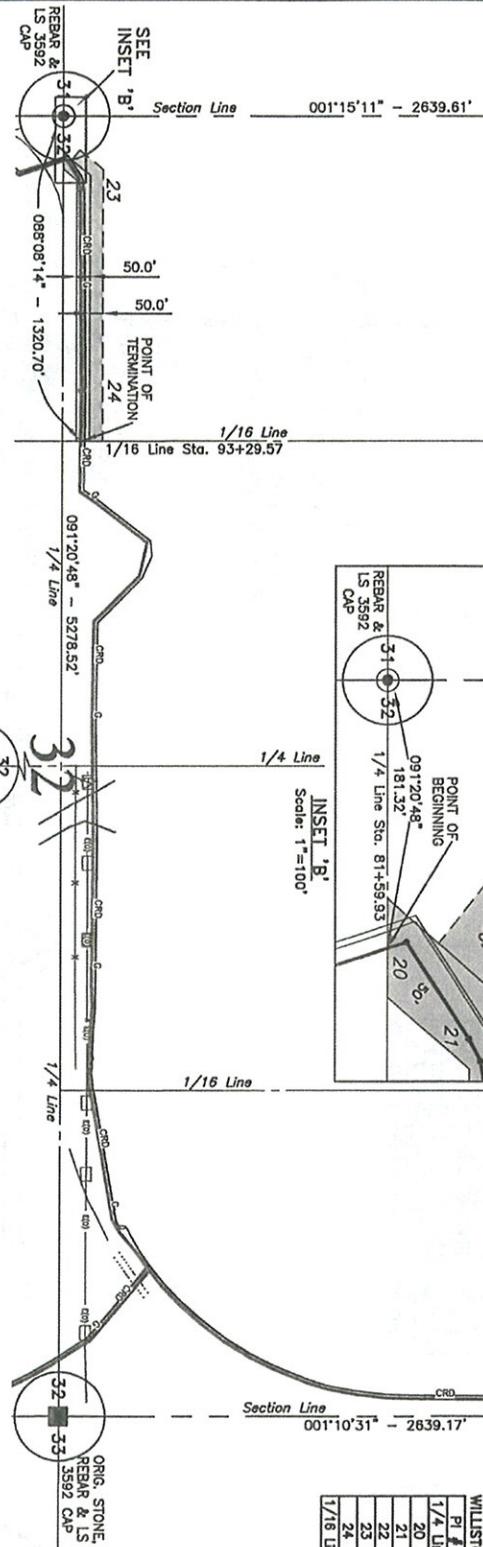

WILLISTON GATHERING SYSTEM WATER LINE			
PI #	STATIONING	DIRECTION	DISTANCE
1/4 Line	81+59.93	343°07'21"	13.58'
20	81+73.51	343°07'21"	77.78'
21	82+51.28	058°58'40"	17.18'
22	82+68.47	064°00'44"	39.83'
23	83+08.30	063°03'27"	090'48.02"
24	91+23.92	091°48'02"	815.62'
1/16 Line	93+29.57	091°54'57"	205.65'

NOTE:
Survey is based on North Dakota State Plane
System, NAD83 (96), North Zone, U.S. Foot
Azimuths shown are Grid Azimuths, distances
show are grid distances. Combined scale factor
= 1.0001430 to go from grid distance to
ground distance.




Kadomas
Lee &
Jackson
Registered Surveyors
Ruston, Montana
1050 17th Street,
Suite 500
Denver, CO
80265-1050
QEP Energy Company
WILLISTON GATHERING SYSTEM WATER LINE
PROPOSED PIPELINE LOCATION ON AND ACROSS THE
W1/2NW1/4 OF SEC. 32, T. 150N., R. 90W.

ALLOTTED TRACT 356A

E 1/2NW 1/4 OF SECTION 32, TOWNSHIP 150 NORTH, RANGE 90 WEST
OF THE 5TH PRINCIPAL MERIDIAN, MCLEAN COUNTY, NORTH DAKOTA

EXHIBIT "A"

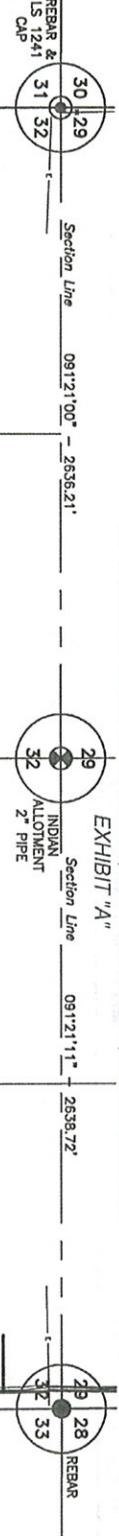

001°15'11" - 2639.61'

ALLOTTED TRACT 356A
1532.83 FEET OR 92.90 RODS

WILLISTON GATHERING SYSTEM WATER LINE			
PI #	STATIONING	DIRECTION	DISTANCE
1/16 Line	93+29.57	091°54'57"	205.52'
25	93+35.09	038°35'31"	339.05'
26	98+74.14	104°29'54"	140.41'
27	100+14.65	136°23'16"	261.50'
28	102+47.65	092°02'23"	415.21'
29	105+91.26	090°43'09"	171.14'
1/4 Line	108+62.40		

1/4 Line Sta. 108+62.40

POINT OF BEGINNING
50.0' 50.0'

POINT OF TERMINATION

1/16 Line

Section Line
001°10'31" - 2639.17'



NOTE: Survey is based on North Dakota State Plane System, NAD83 (96), North Zone, U.S. Foothills.


Azimuths shown are Grid Azimuths, distances shown are grid distance. Combined scale factor = 1.0001430 to go from grid distance to ground distance.

Kadamus Lee & Jackson Engineers Surveyors		1030 17th Street, Suite 500 Denver, CO 80265-1050	QEP FIELD SERVICES	SHEET 12 OF 34
REB A R E P. Energy Company		WILLISTON GATHERING SYSTEM WATER LINE	PROPOSED PIPELINE LOCATION ON AND ACROSS THE	DWG NO. 3709480base5
DEAN M. S. Wolf		001°10'31" - 2639.17'	E 1/2NW 1/4 OF SEC. 32, T. 150N, R. 90W.	JOB NO. 3709480

ALLOTTED TRACT 354A-A

W1/2NE1/4 OF SECTION 32, TOWNSHIP 150 NORTH, RANGE 90 WEST
OF THE 5TH PRINCIPAL MERIDIAN, MCLEAN COUNTY, NORTH DAKOTA


EXHIBIT "A"

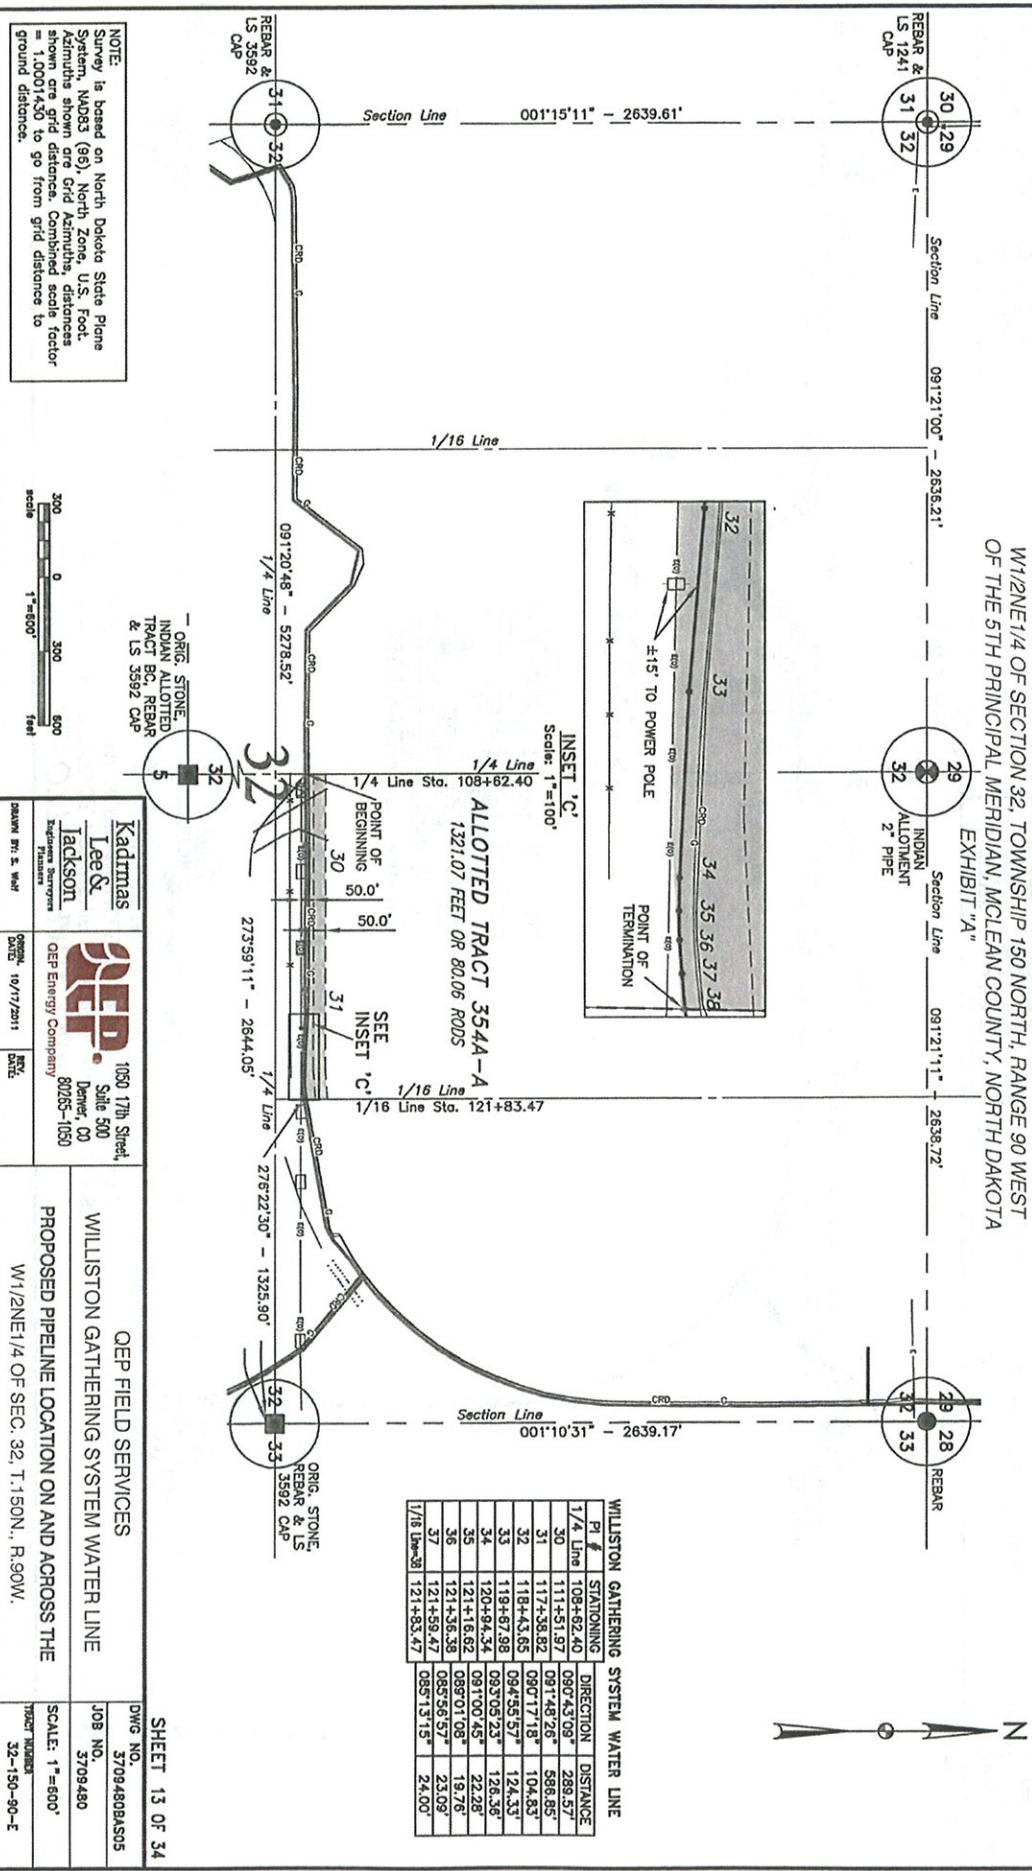

THREE AFFILIATED TRIBES


E 1/2 NE 1/4 OF SECTION 32, TOWNSHIP 150 NORTH, RANGE 90 WEST
OF THE 5TH PRINCIPAL MERIDIAN, MCLEAN COUNTY, NORTH DAKOTA

EXHIBIT "A"

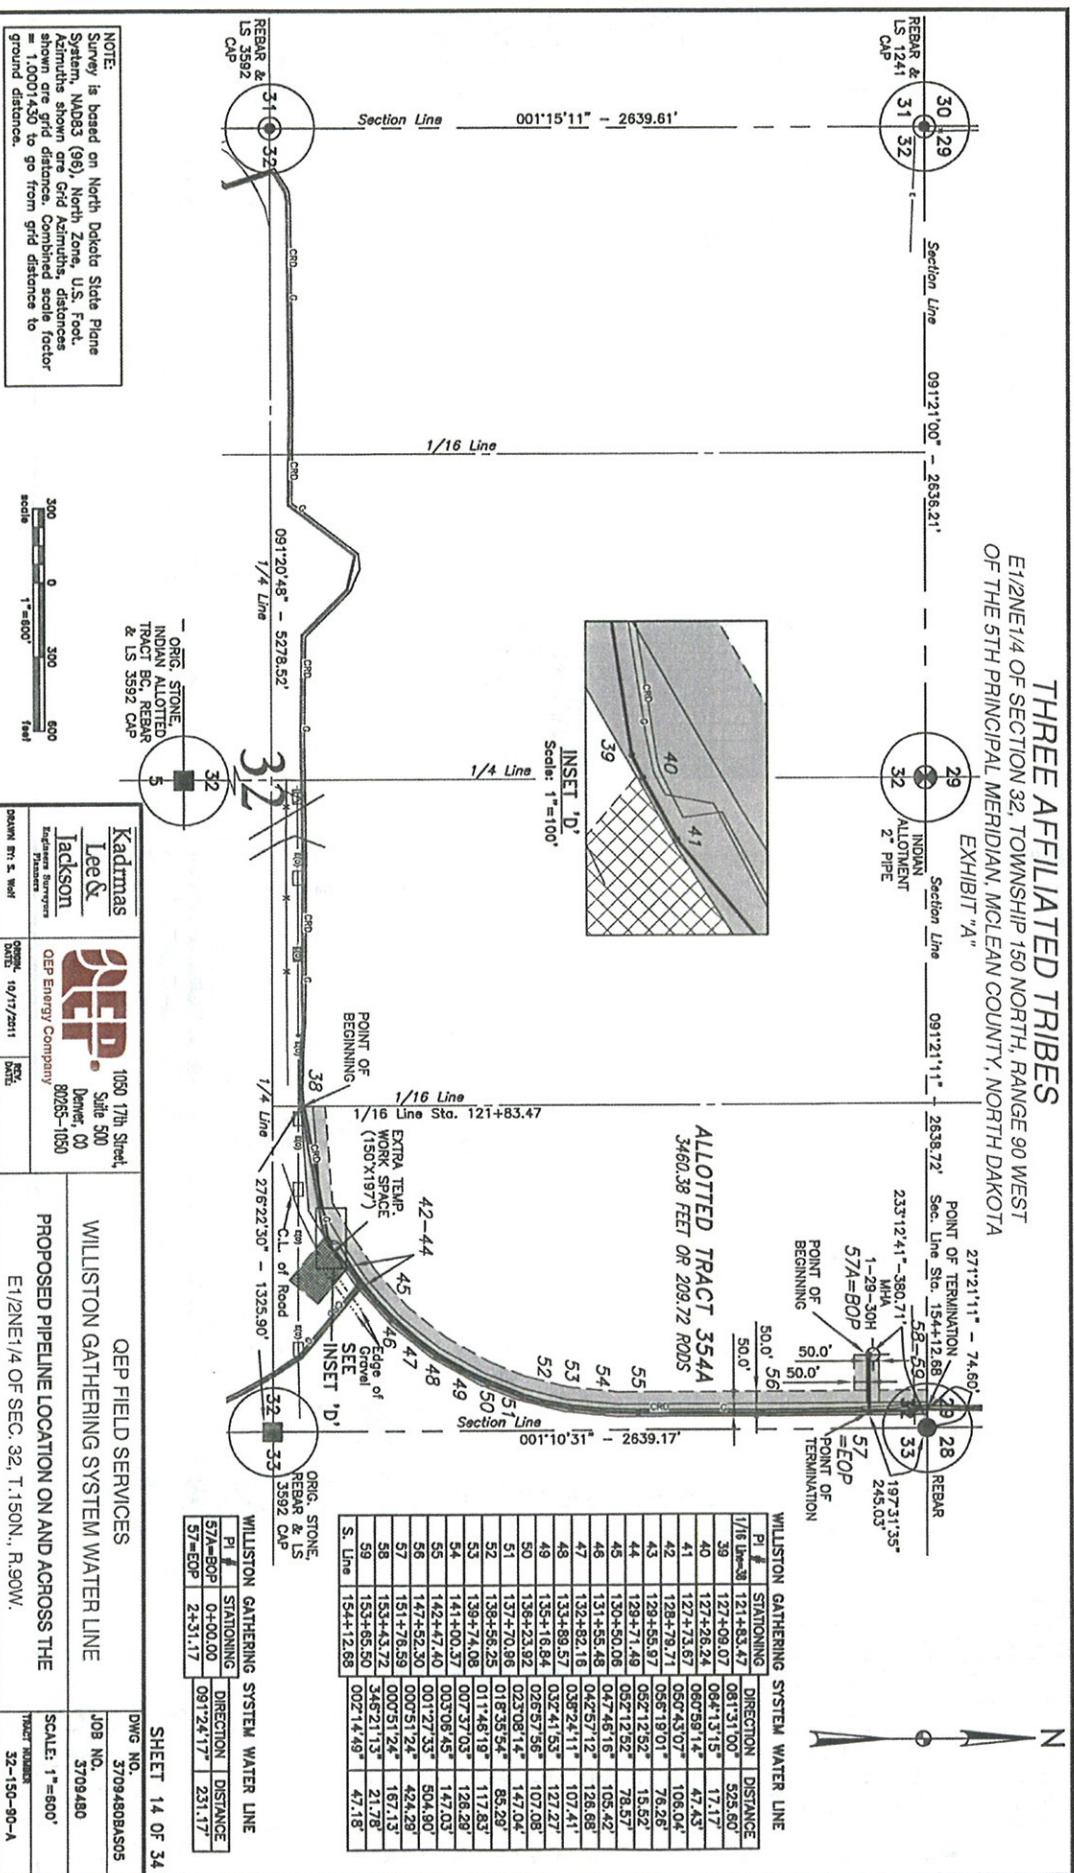

NETTIE IVERSON

E1/2SE1/4 OF SECTION 29, TOWNSHIP 150 NORTH, RANGE 90 WEST
OF THE 5TH PRINCIPAL MERIDIAN, MCLEAN COUNTY, NORTH DAKOTA
EXHIBIT "A"

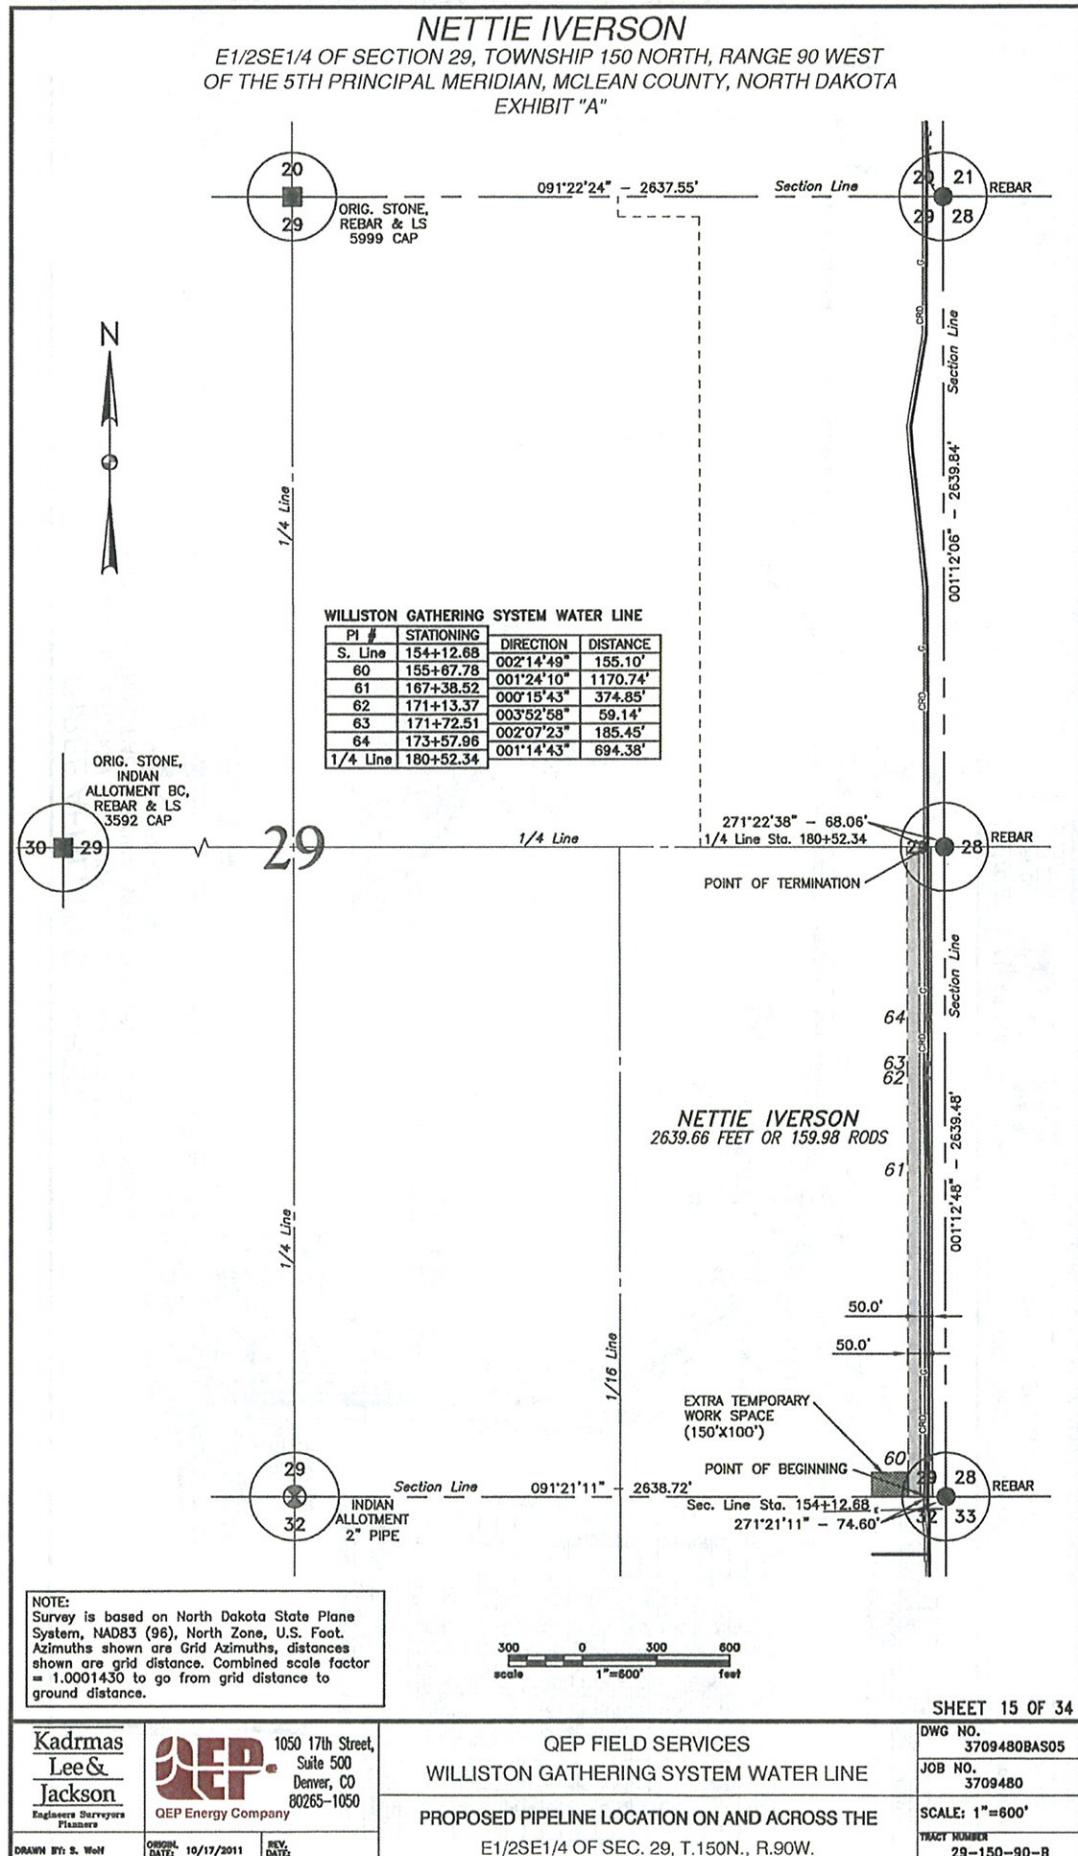

SHEET 15 OF 34

Kadrmas
Lee &
Jackson
Engineers Surveyors
Planners



1050 17th Street,
Suite 500
Denver, CO
80265-1050
QEP Energy Company

QEP FIELD SERVICES

WILLISTON GATHERING SYSTEM WATER LINE

PROPOSED PIPELINE LOCATION ON AND ACROSS THE
E1/2SE1/4 OF SEC. 29, T.150N., R.90W.

DWG NO.
3709480BAS05

JOB NO.
3709480

SCALE: 1"=600'
TRACT NUMBER
29-150-90-B


DRAWN BY: S. Wolf

ORIGINAL DATE: 10/17/2011

REV. DATE:


THREE AFFILIATED TRIBES

E1/2/E1/2NE1/4, E1/2W1/2E1/2NE1/4, and N1/2N1/2NW1/4NW1/4NE1/4NE1/4
OF SECTION 29, TOWNSHIP 150 NORTH, RANGE 90 WEST
OF THE 5TH PRINCIPAL MERIDIAN, MCLEAN COUNTY, NORTH DAKOTA
EXHIBIT "A"

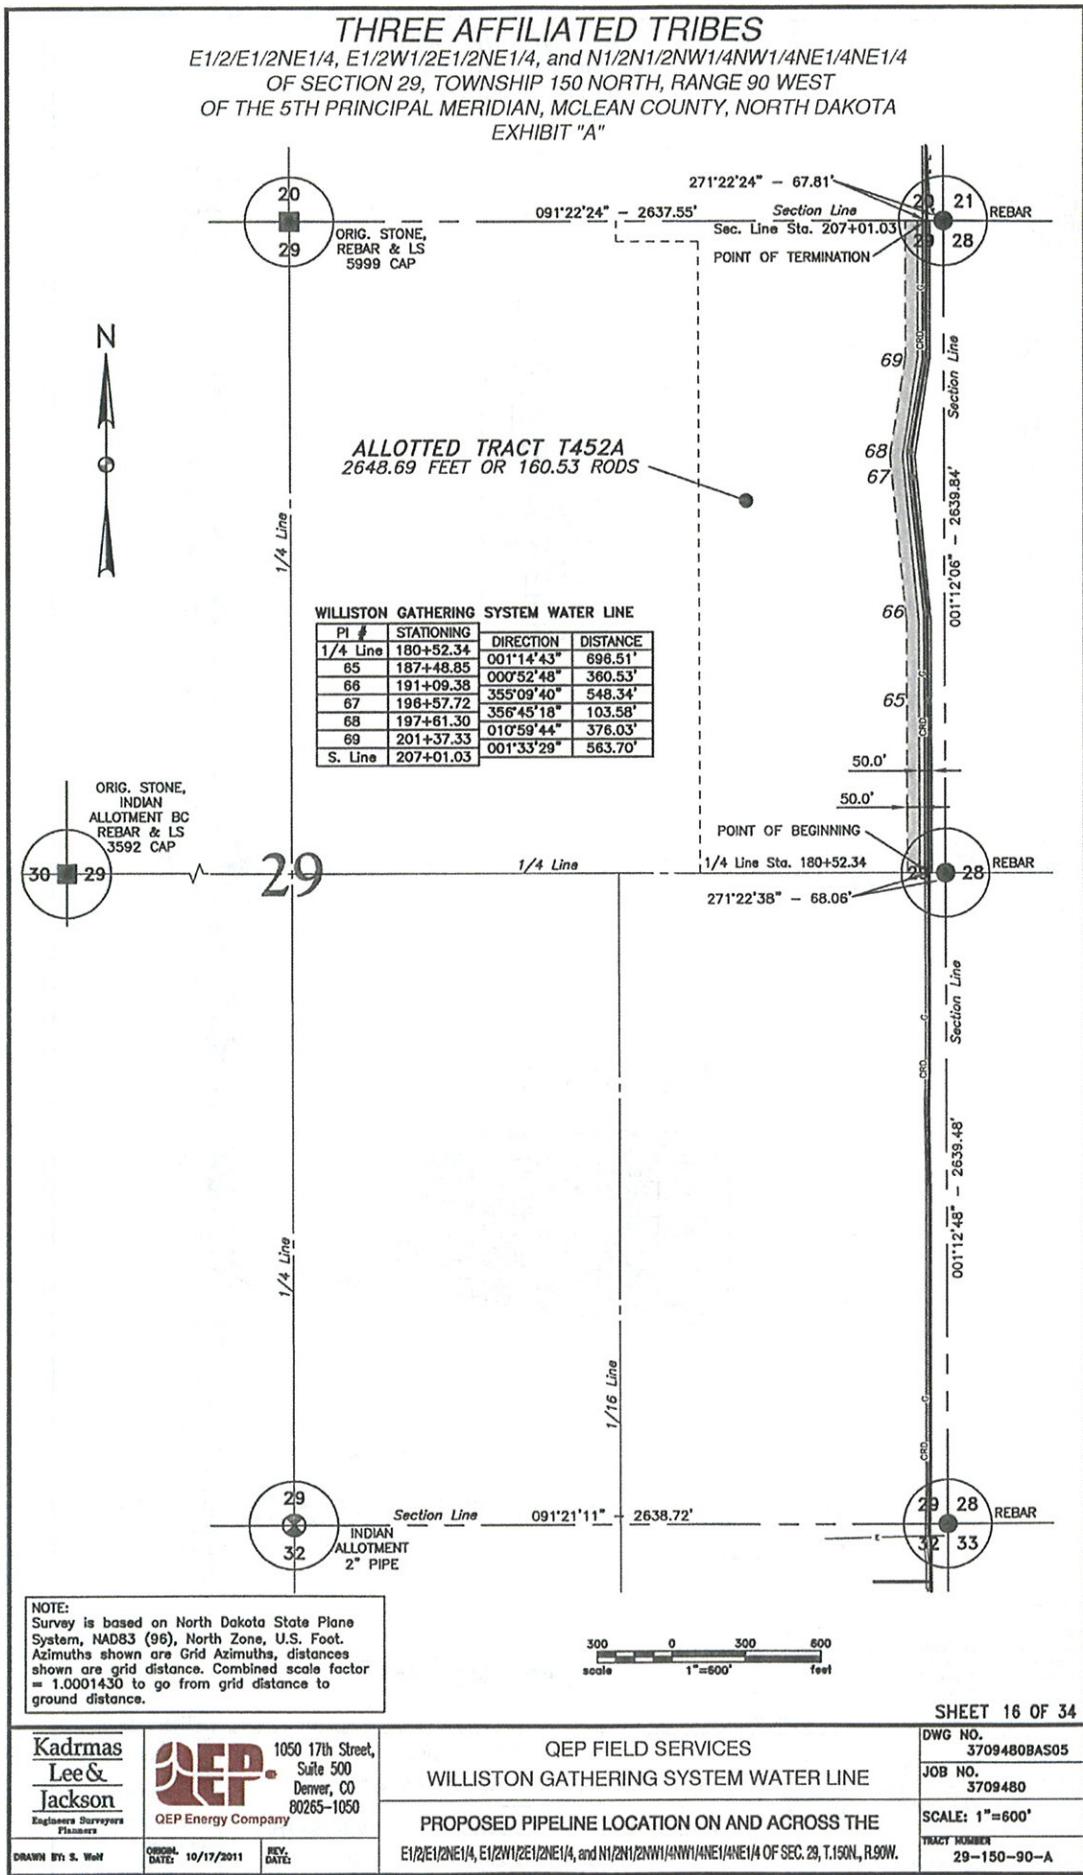

JAMES I. and MARJORIE MYERS

SE 1/4 OF SECTION 20, TOWNSHIP 150 NORTH, RANGE 90 WEST
OF THE 5TH PRINCIPAL MERIDIAN, MCLEAN COUNTY, NORTH DAKOTA
EXHIBIT "A"

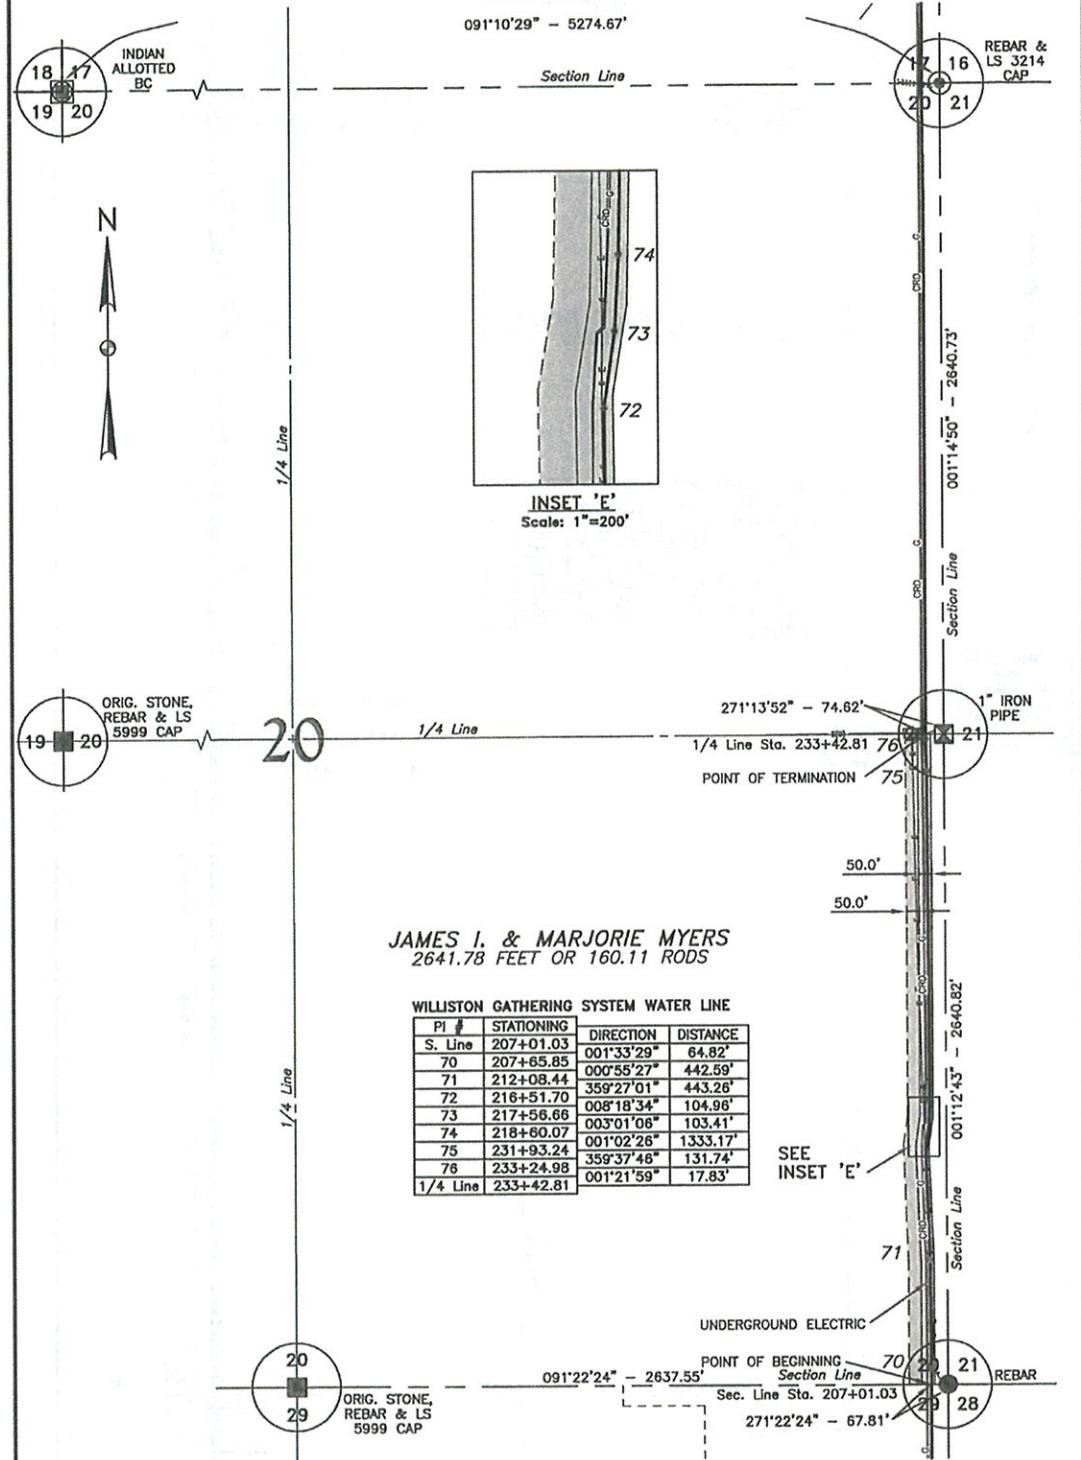

SHEET 17 OF 34

Kadmas
Lee &
Jackson
Engineers Surveyors
Planners



1050 17th Street,
Suite 500
Denver, CO
80265-1050

QEP FIELD SERVICES
WILLISTON GATHERING SYSTEM WATER LINE
PROPOSED PIPELINE LOCATION ON AND ACROSS THE
SE 1/4 OF SEC. 20, T. 150 N., R. 90 W.

DWG NO.
3709480BAS05
JOB NO.
3709480
SCALE: 1"=600'
TRACT NUMBER
20-150-90-B
LAYOUT: SE_20-150-90


DRAWN BY S. W.M.

ORIGINAL DATE: 10/17/2011

REV. DATE:

THREE AFFILIATED TRIBES

NE 1/4 OF SECTION 20, TOWNSHIP 150 NORTH, RANGE 90 WEST
OF THE 5TH PRINCIPAL MERIDIAN, MCLEAN COUNTY, NORTH DAKOTA
EXHIBIT "A"

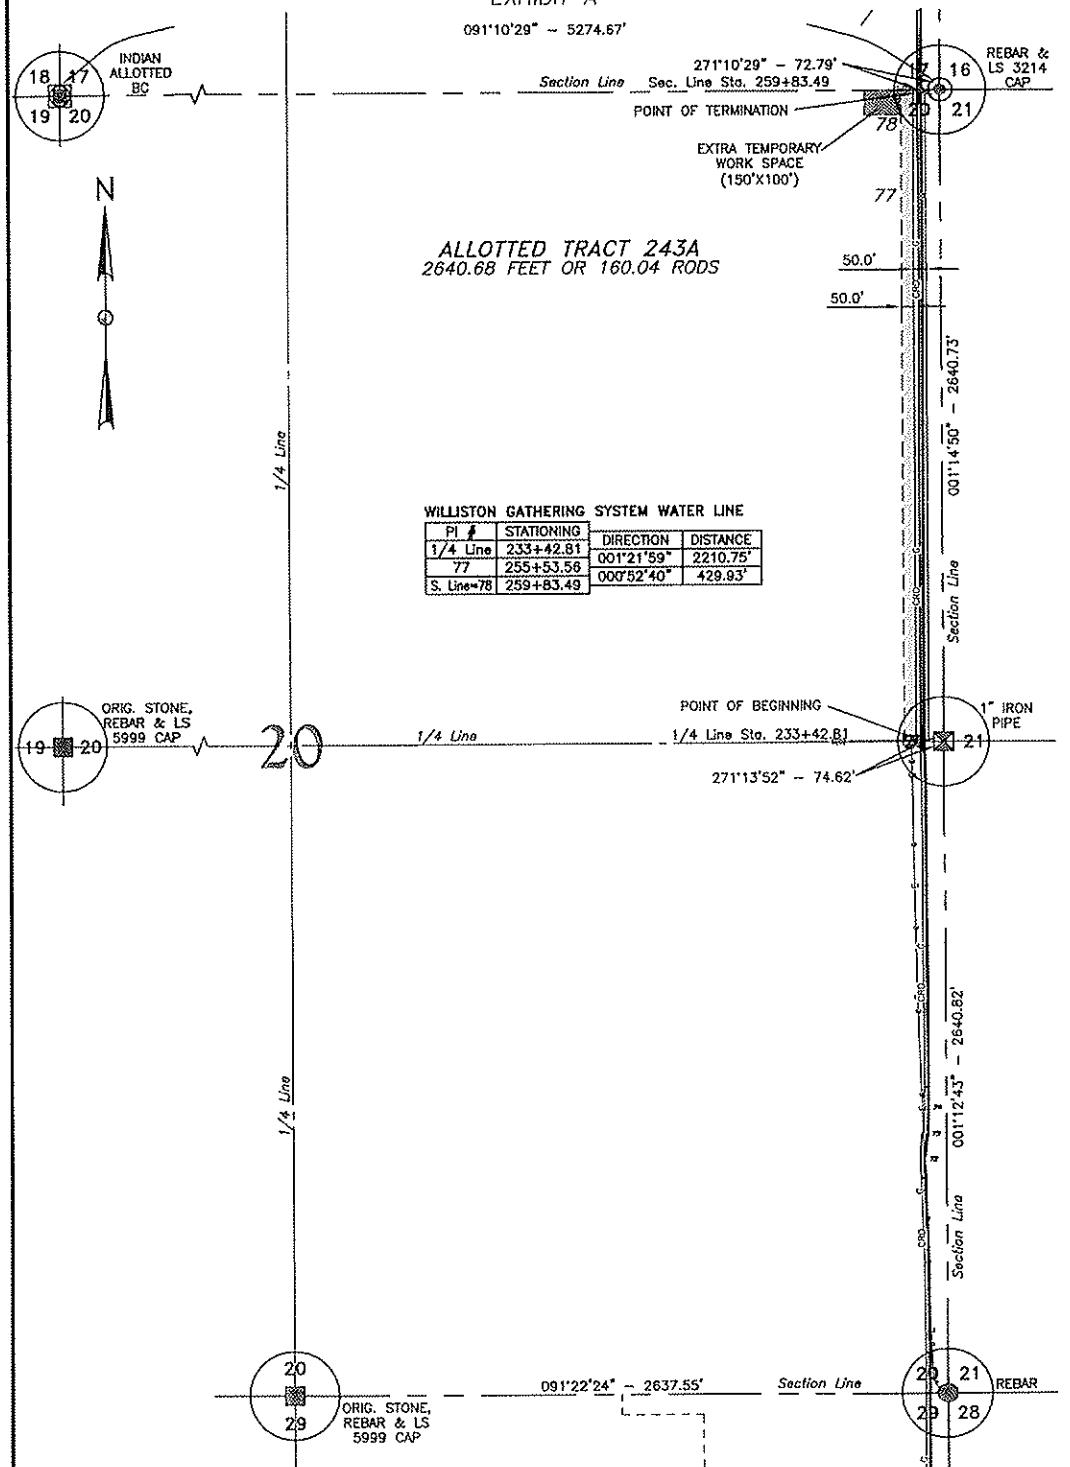

SHEET 18 OF 34

Kadomas
Lee &
Jackson
Engineering Services
Firm Inc.



1050 17th Street,
Suite 500
Denver, CO
80265-1050

QEP Energy Company

QEP FIELD SERVICES

WILLISTON GATHERING SYSTEM WATER LINE

DWG NO.
3709480BASD5

JOB NO.
3709480

PROPOSED PIPELINE LOCATION ON AND ACROSS THE

SCALE: 1"=600'

NE 1/4 OF SEC. 20, T.150N., R.90W.

TRACT NUMBER
20-150-90-A


DRAWN BY S. Wohl

ORIGIN DATE
10/17/2011

REV. DATE

ALLOTTED TRACT 245A

SE 1/4 OF SECTION 17, TOWNSHIP 150 NORTH, RANGE 90 WEST
OF THE 5TH PRINCIPAL MERIDIAN, MCLEAN COUNTY, NORTH DAKOTA
EXHIBIT "A"

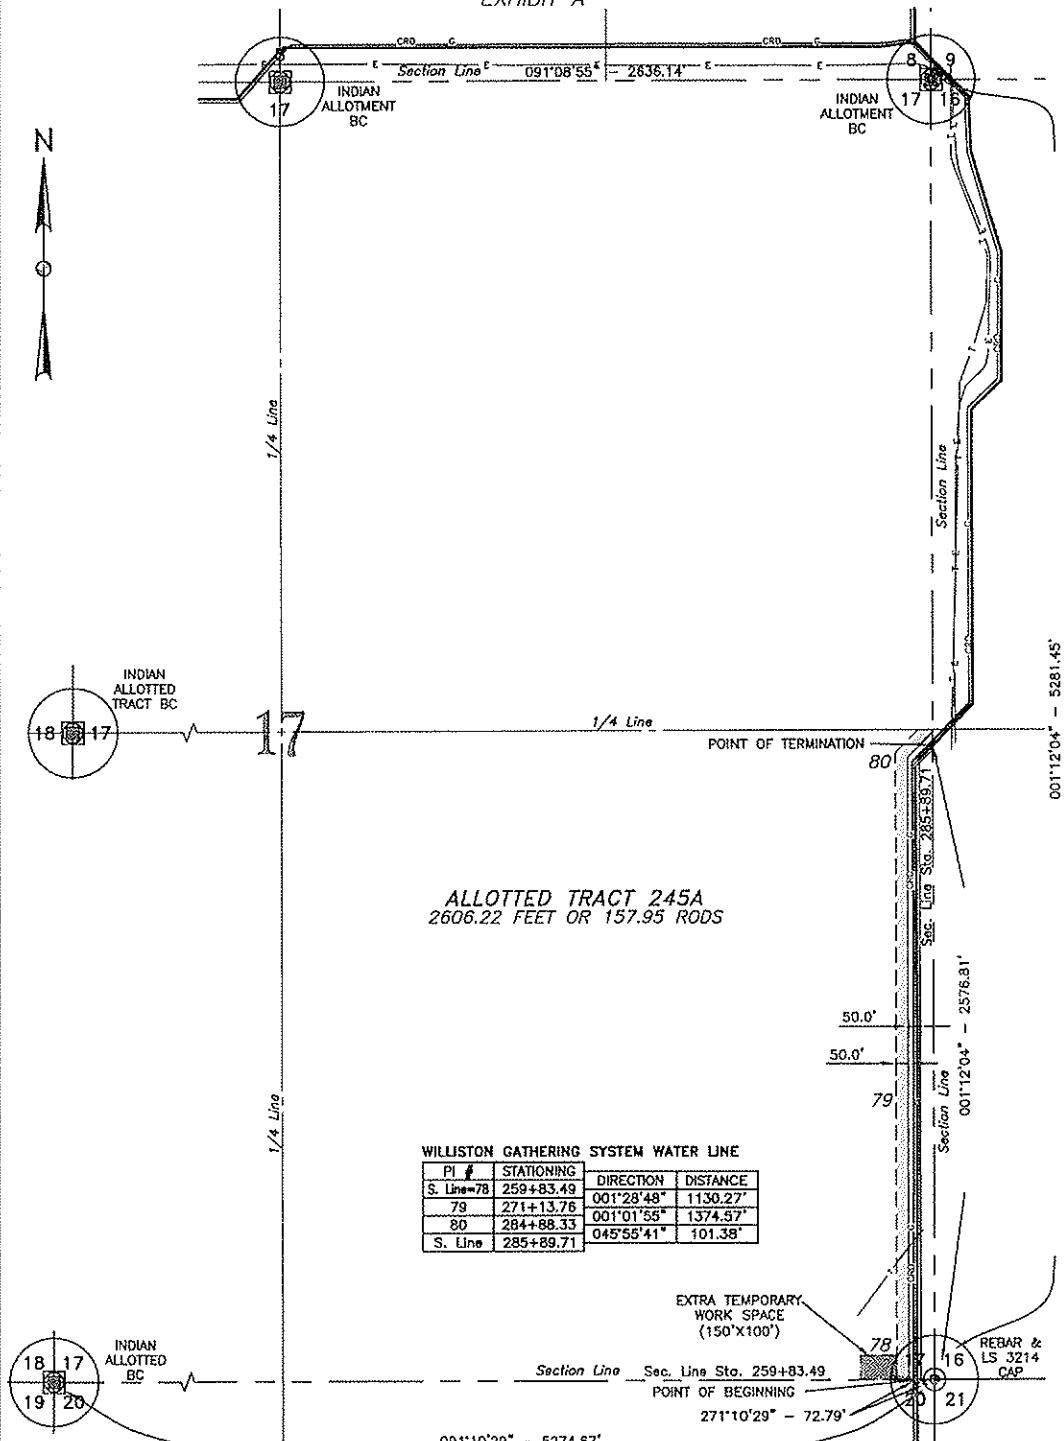

NOTE:
Survey is based on North Dakota State Plane System, NAD83 (96), North Zone, U.S. Feet.
Azimuths shown are Grid Azimuths, distances shown are grid distance. Combined scale factor = 1.0001430 to go from grid distance to ground distance.

300 0 300 600
scale 1"=600' feet

SHEET 19 OF 34

Kadrimas
Lee &
Jackson
Engineers Surveyors
Planners



1050 17th Street,
Suite 500
Denver, CO
80265-1050
OEP Energy Company

QEP FIELD SERVICES

WILLISTON GATHERING SYSTEM WATER LINE

PROPOSED PIPELINE LOCATION ON AND ACROSS THE
SE 1/4 OF SEC. 17, T.150N., R.90W.

DWG NO.
3709480BAS05

JOB NO.
3709480

SCALE: 1"=600'
TRACT NUMBER
17-150-90-B

DRAWN BY: S. Wolf


ORDER DATE: 10/17/2011

REV.
000

ALLOTTED TRACT T287A

SW1/4 OF SECTION 16, TOWNSHIP 150 NORTH, RANGE 90 WEST
OF THE 5TH PRINCIPAL MERIDIAN, MCLEAN COUNTY, NORTH DAKOTA
EXHIBIT "A"

091°16'39" - 5275.04'

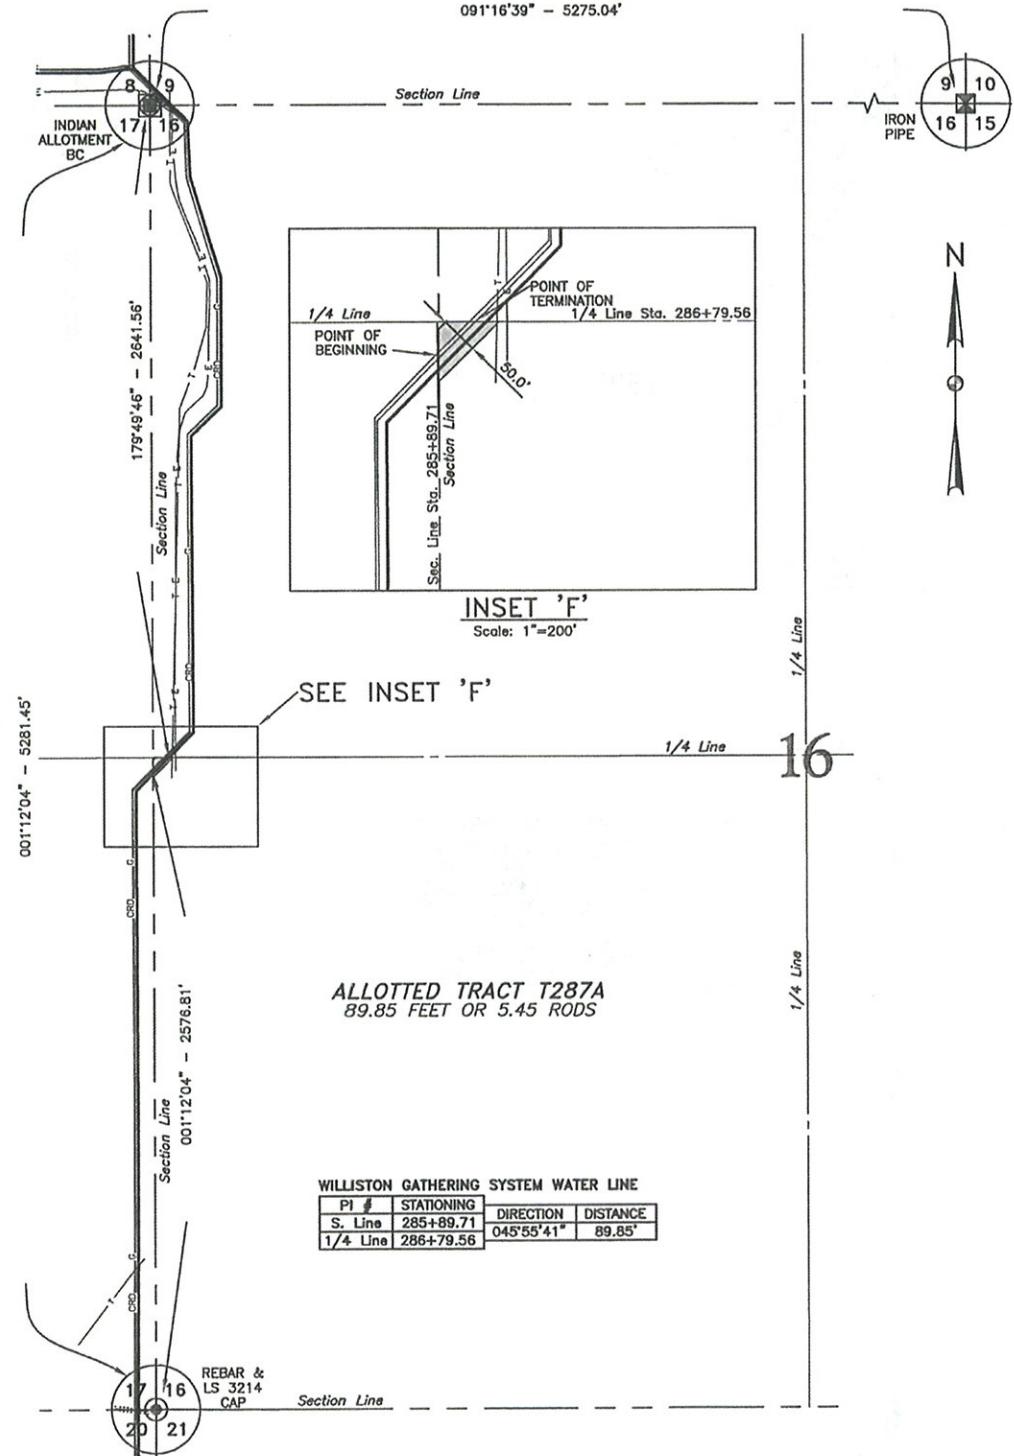

NOTE:
Survey is based on North Dakota State Plane System, NADB3 (96), North Zone, U.S. Foot.
Azimuths shown are Grid Azimuths, distances shown are grid distance. Combined scale factor = 1.0001430 to go from grid distance to ground distance.

300 0 300 600
scale 1"=800' feet

SHEET 20 OF 34

Kadrmas
Lee &
Jackson
Engineers Surveyors
Planners



1050 17th Street,
Suite 500
Denver, CO
80265-1050

QEP FIELD SERVICES
WILLISTON GATHERING SYSTEM WATER LINE

DWG NO.
3709480BAS05

JOB NO.
3709480

PROPOSED PIPELINE LOCATION ON AND ACROSS THE
SW1/4 OF SEC. 16, T.150N., R.90W.

SCALE: 1"=600'
TRACT NUMBER
16-150-90-B

DRAWN BY S. Wolf


ORIGINAL DATE: 10/17/2011

REV. DATE:

JAMES & DAN WALDOCK

NW1/4 OF SECTION 16, TOWNSHIP 150 NORTH, RANGE 90 WEST
OF THE 5TH PRINCIPAL MERIDIAN, MCLEAN COUNTY, NORTH DAKOTA
EXHIBIT "A"

091°16'39" - 5275.04'

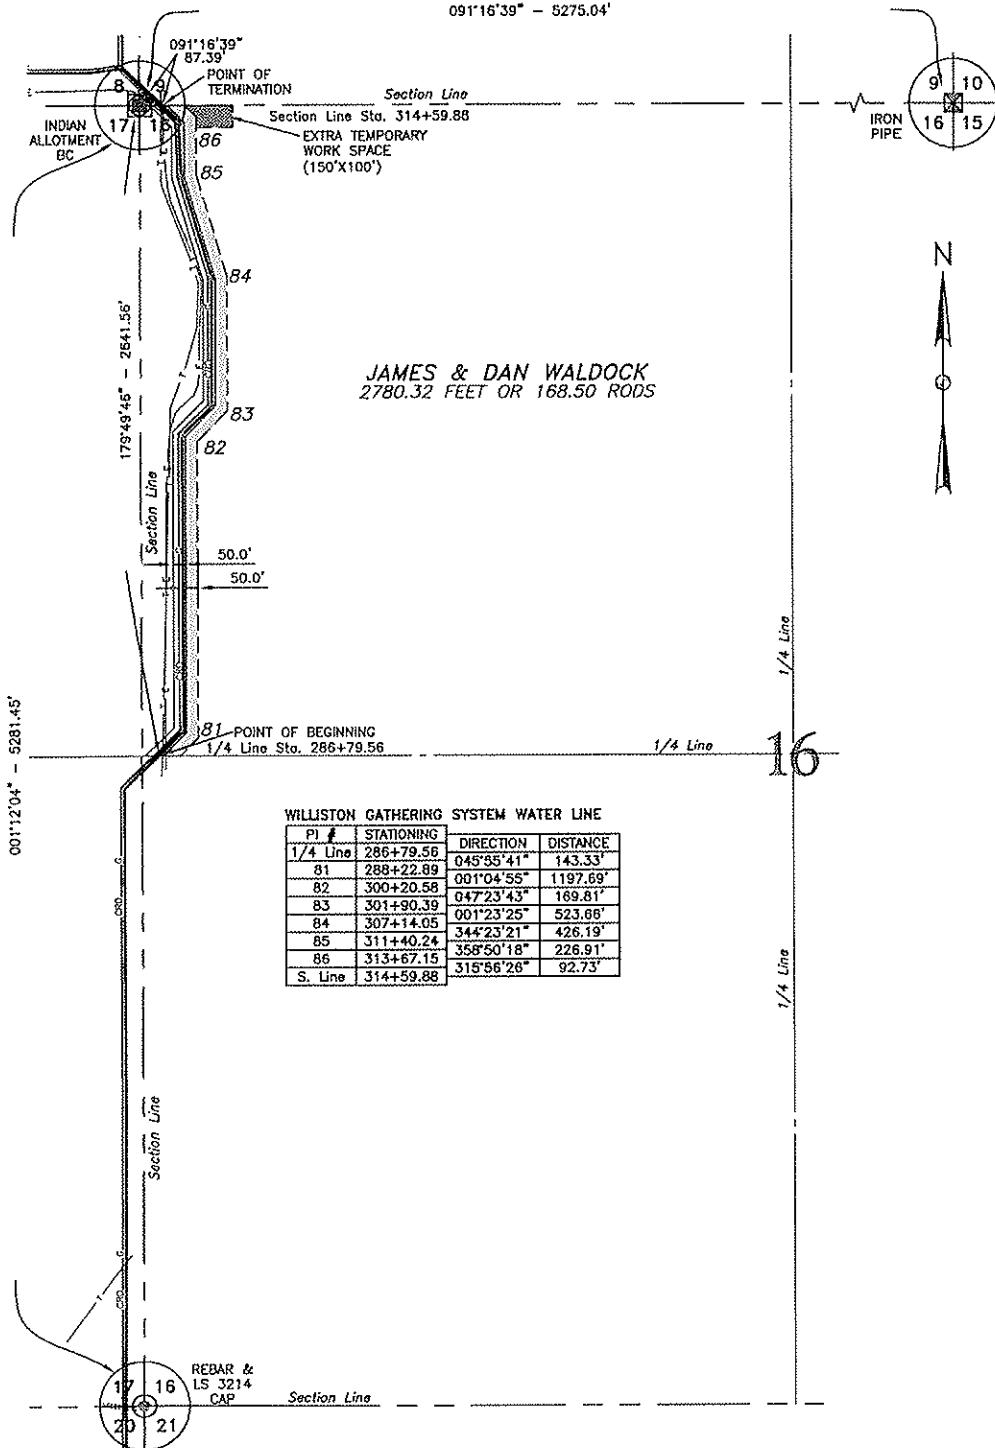

NOTE:
Survey is based on North Dakota State Plane System, NAD83 (96), North Zone, U.S. Foot.
Azimuths shown are Grid Azimuths, distances shown are grid distance. Combined scale factor = 1.0001430 to go from grid distance to ground distance.

300 0 300 800
scale 1"=600' feet

SHEET 21 OF 34

Kadomas
Lee &
Jackson
Engineers Surveyors
Planners



1050 17th Street
Suite 500
Denver, CO
80265-1050
QEP Energy Company

QEP FIELD SERVICES

WILLISTON GATHERING SYSTEM WATER LINE

DWG NO.
3709480BASD5

JOB NO.
3709480

SCALE: 1"=600'
TRACT NUMBER
16-150-90-A


PROPOSED PIPELINE LOCATION ON AND ACROSS THE
NW1/4 OF SEC. 16, T.150N., R.90W.

DRAWN BY S. WOH

ORIGINAL DATE: 10/17/2011


PREV. DATE:

ALLOTTED TRACT 264A-B
 S1/2SW1/4 OF SECTION 9, TOWNSHIP 150 NORTH, RANGE 90 WEST
 OF THE 5TH PRINCIPAL MERIDIAN, MCLEAN COUNTY, NORTH DAKOTA
 EXHIBIT "A"

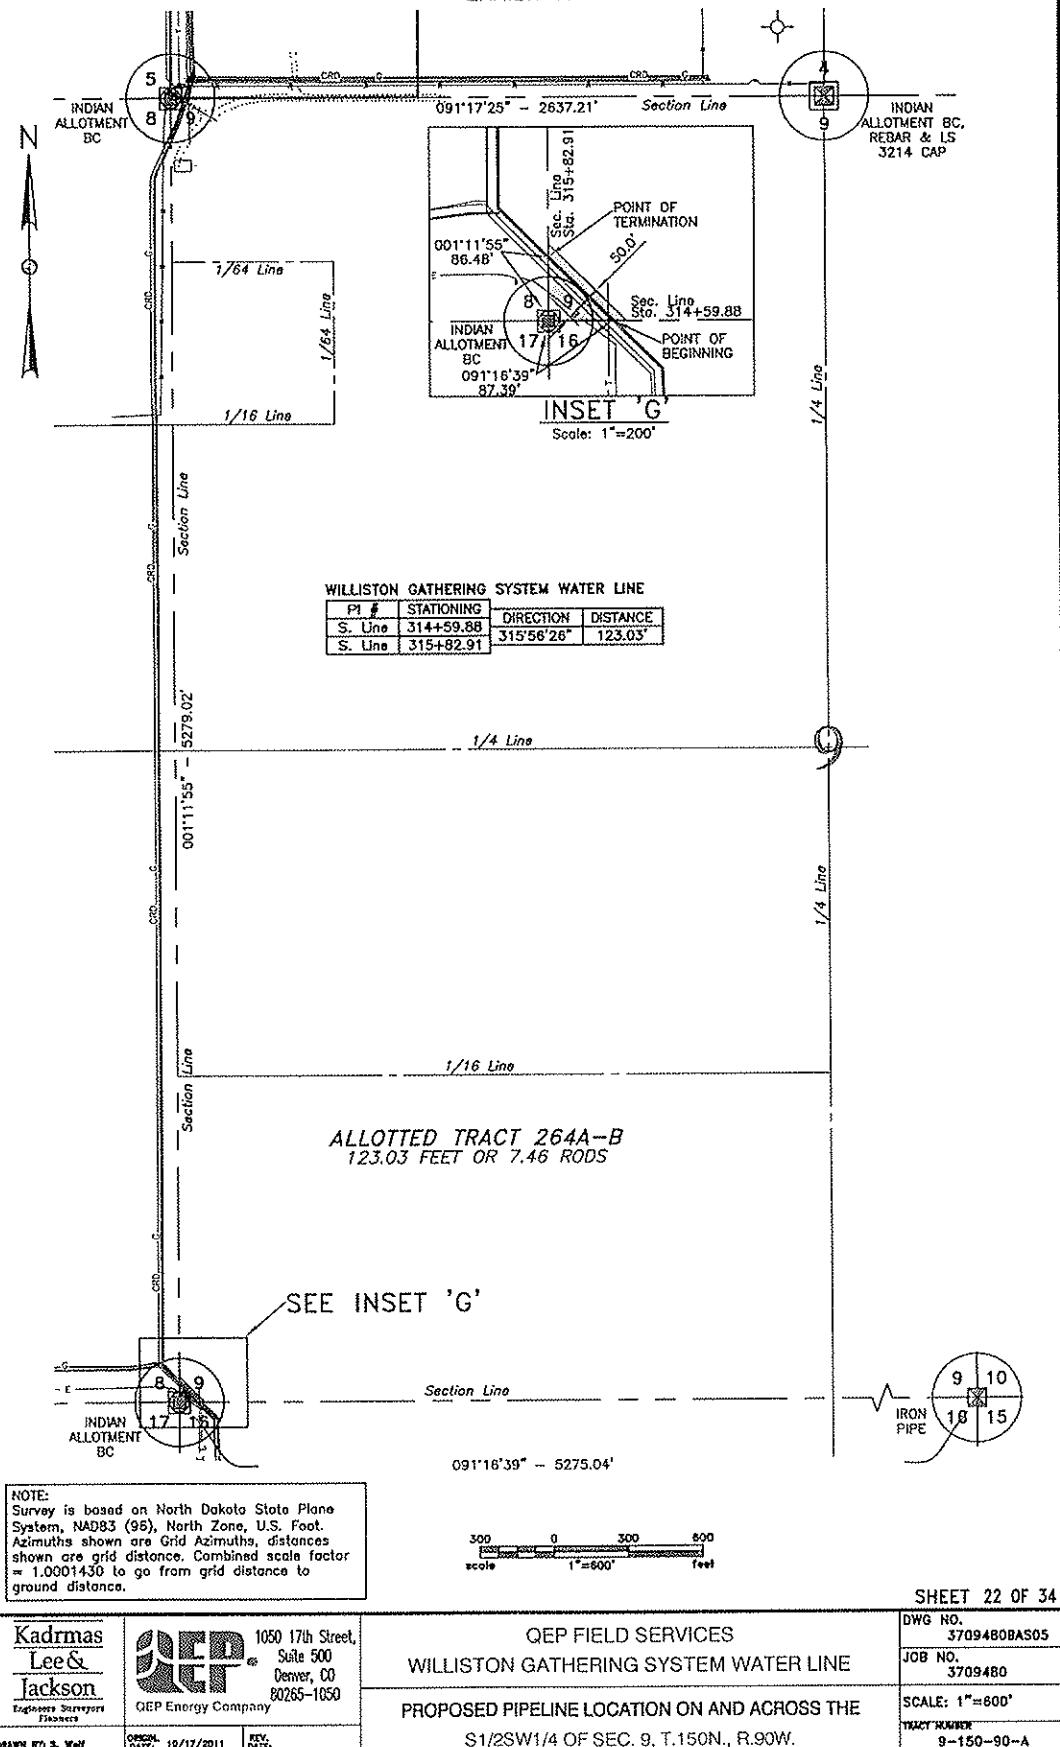


ALLOTTED TRACT 1518

E1/2SE1/4 OF SECTION 8, TOWNSHIP 150 NORTH, RANGE 90 WEST
OF THE 5TH PRINCIPAL MERIDIAN, MCLEAN COUNTY, NORTH DAKOTA
EXHIBIT "A"

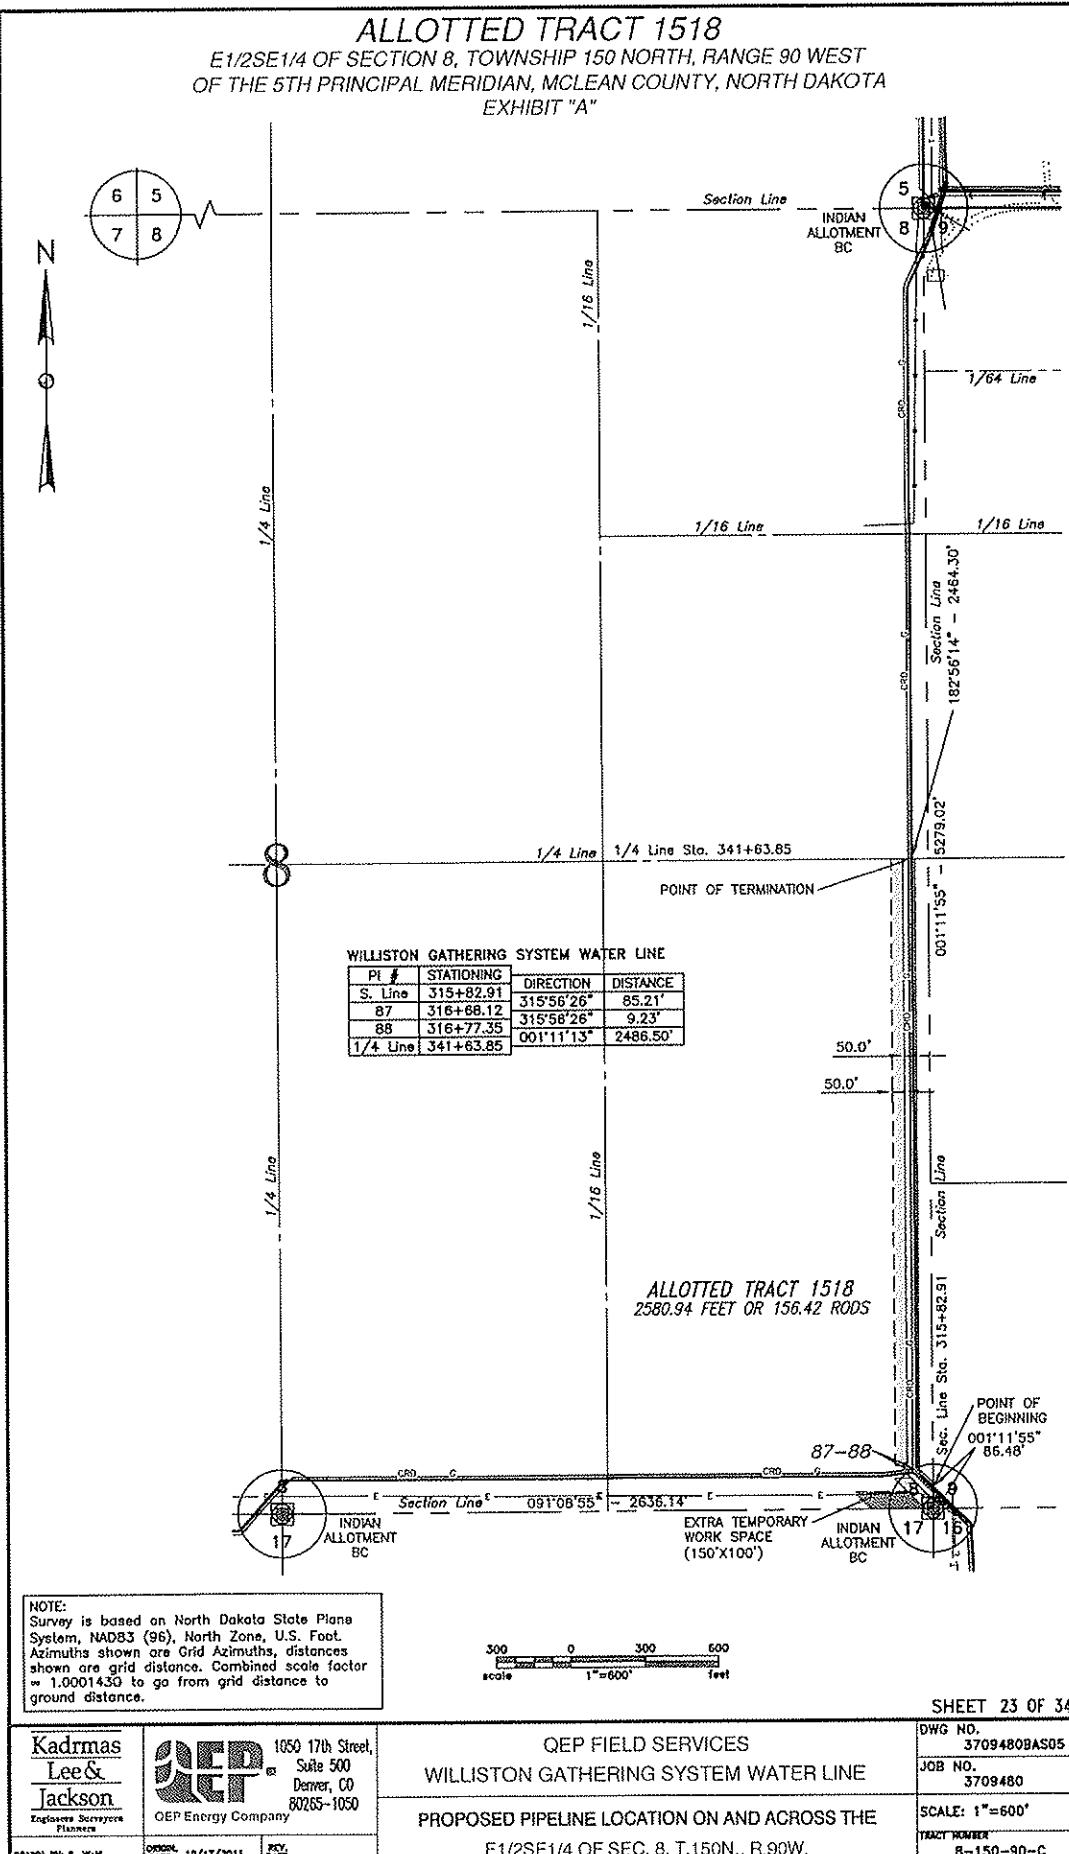


JAMES and DEAN WALDOCK

SE1/4NE1/4 OF SECTION 8, TOWNSHIP 150 NORTH, RANGE 90 WEST
OF THE 5TH PRINCIPAL MERIDIAN, MCLEAN COUNTY, NORTH DAKOTA
EXHIBIT "A"

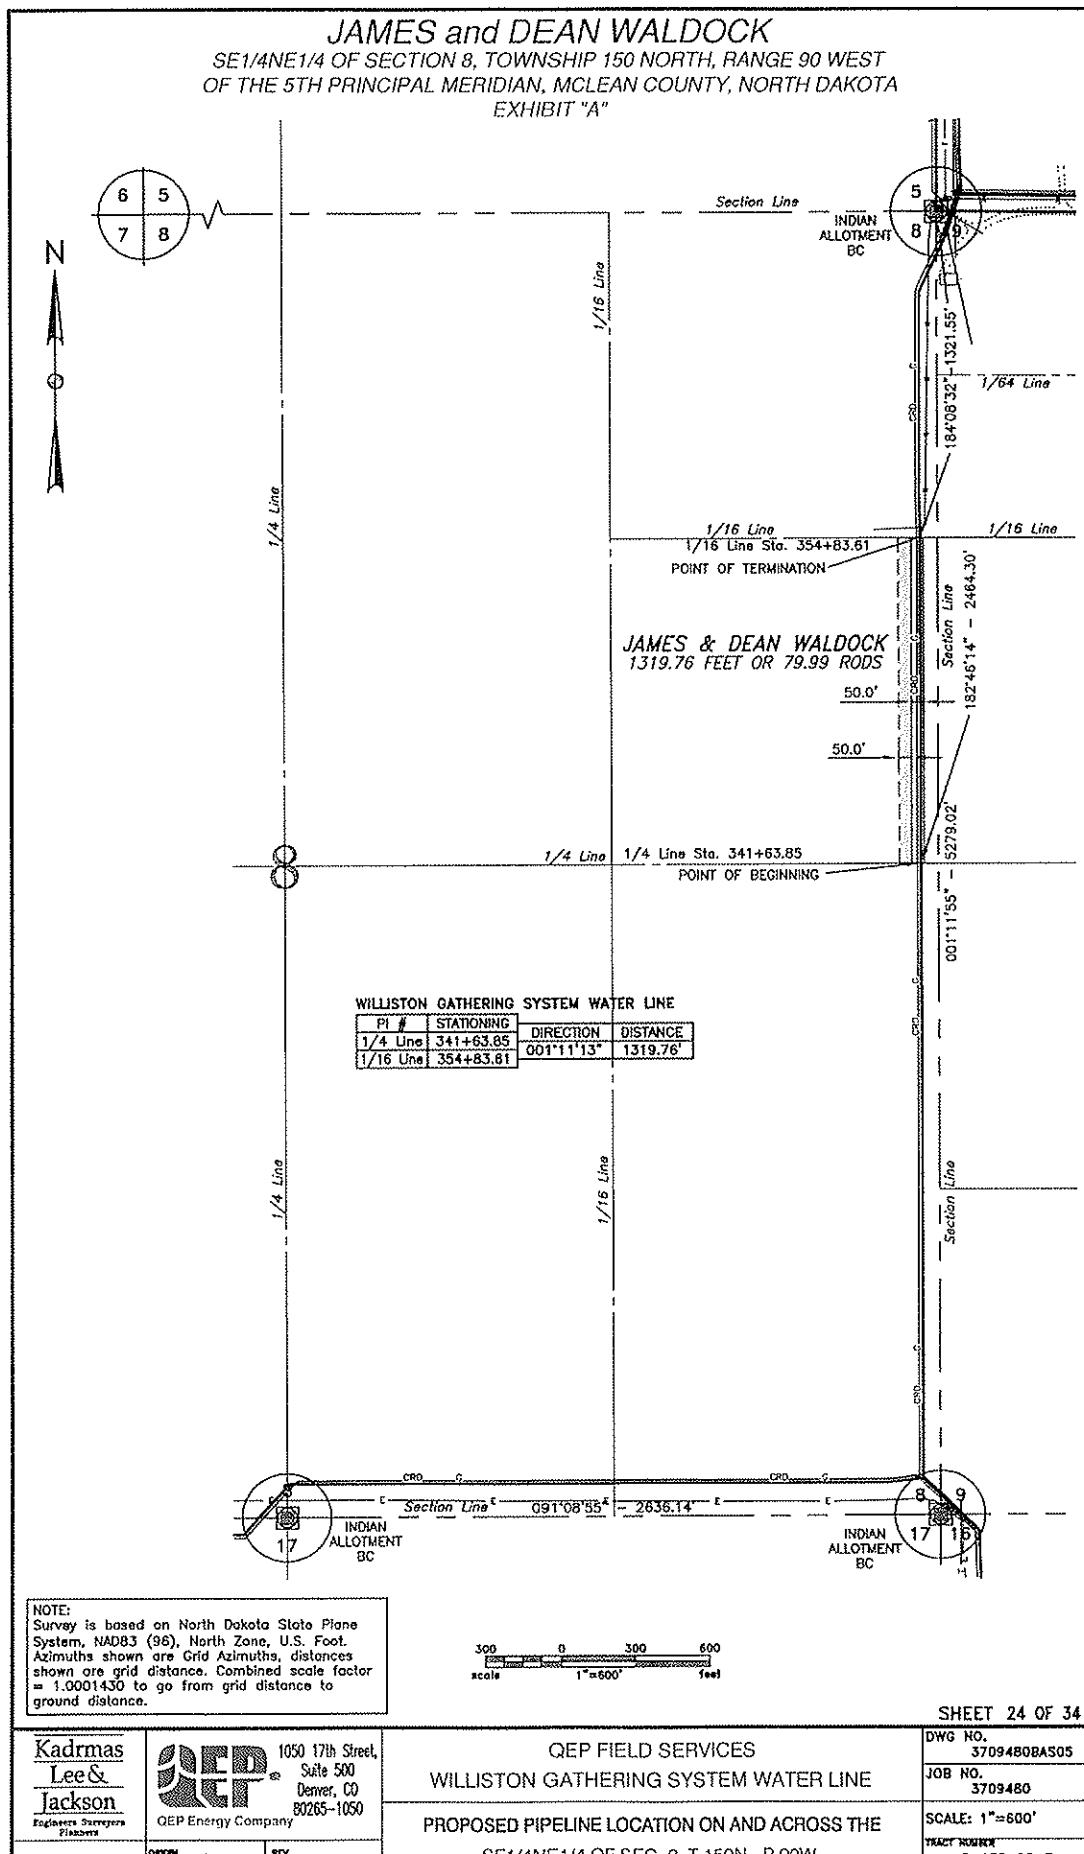


THREE AFFILIATED TRIBES

NE1/4NE1/4 OF SECTION 8, TOWNSHIP 150 NORTH, RANGE 90 WEST
OF THE 5TH PRINCIPAL MERIDIAN, MCLEAN COUNTY, NORTH DAKOTA
EXHIBIT "A"

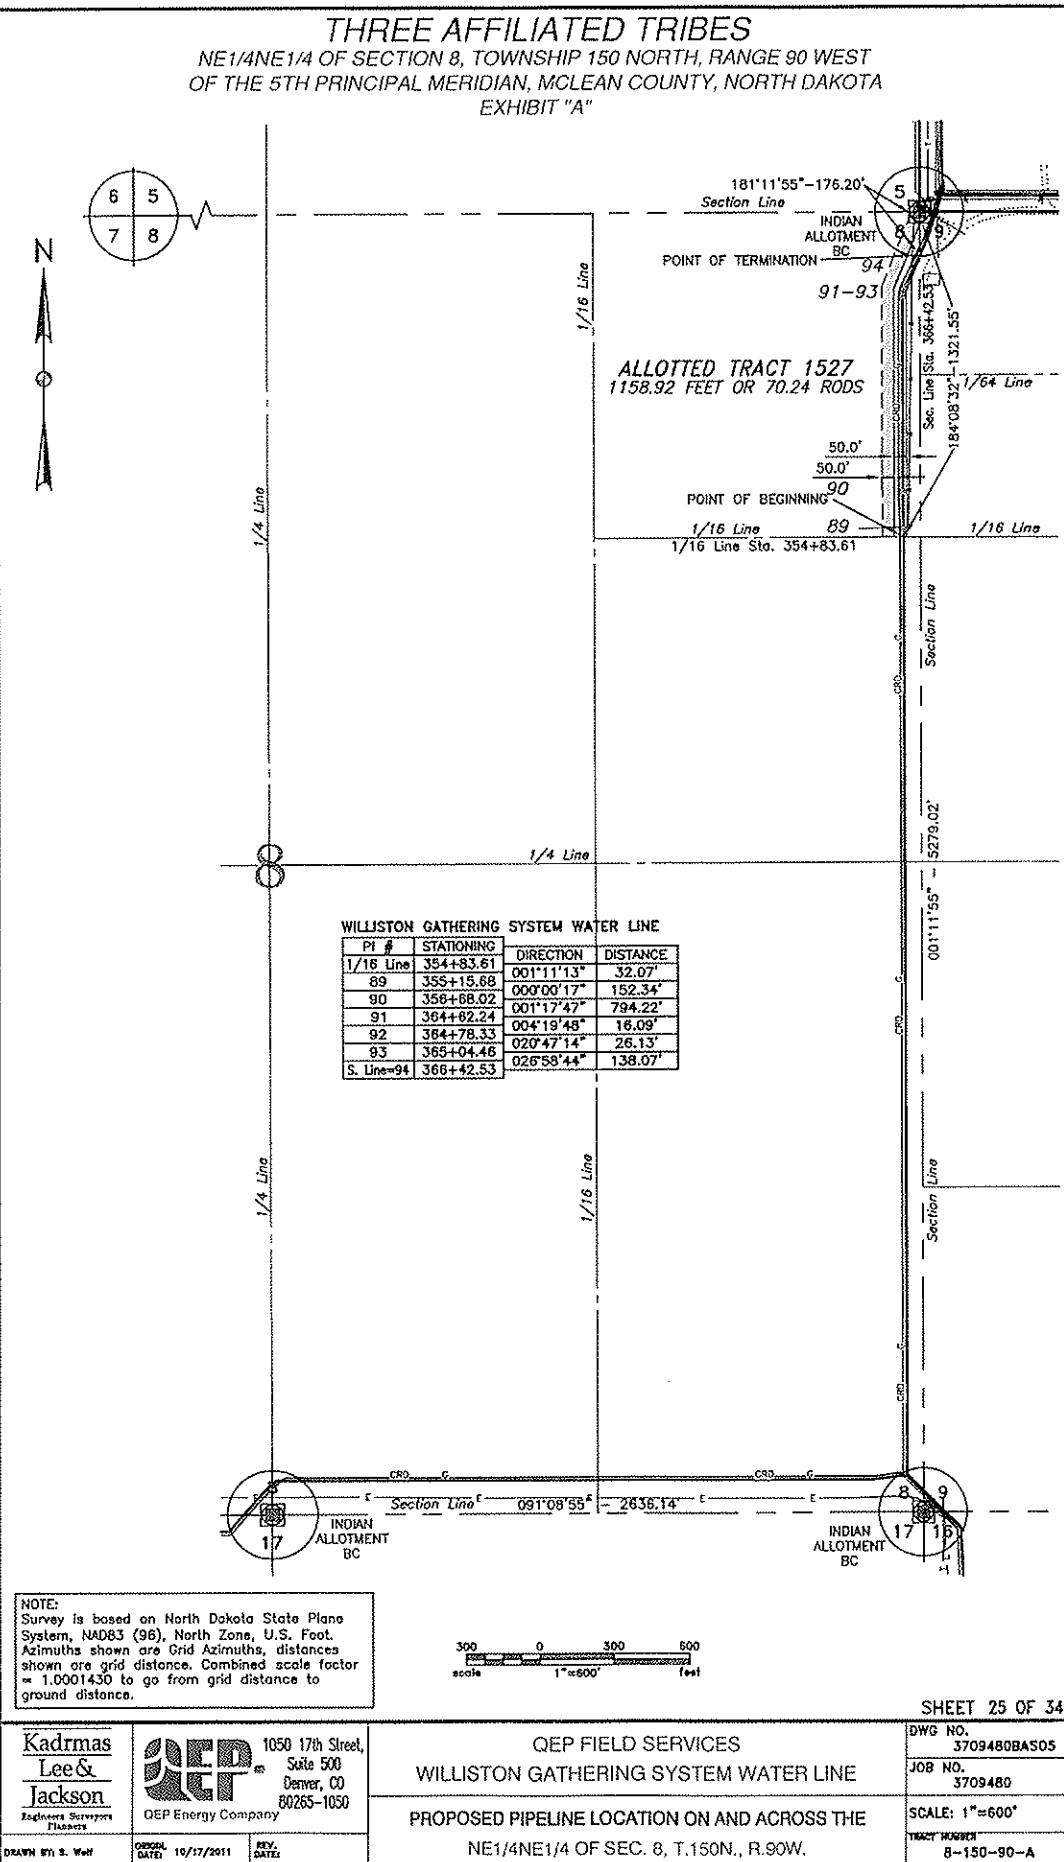


THREE AFFILIATED TRIBES

NW1/4NW1/4NW1/4 OF SECTION 9, TOWNSHIP 150 NORTH, RANGE 90 WEST
OF THE 5TH PRINCIPAL MERIDIAN, MCLEAN COUNTY, NORTH DAKOTA
EXHIBIT "A"

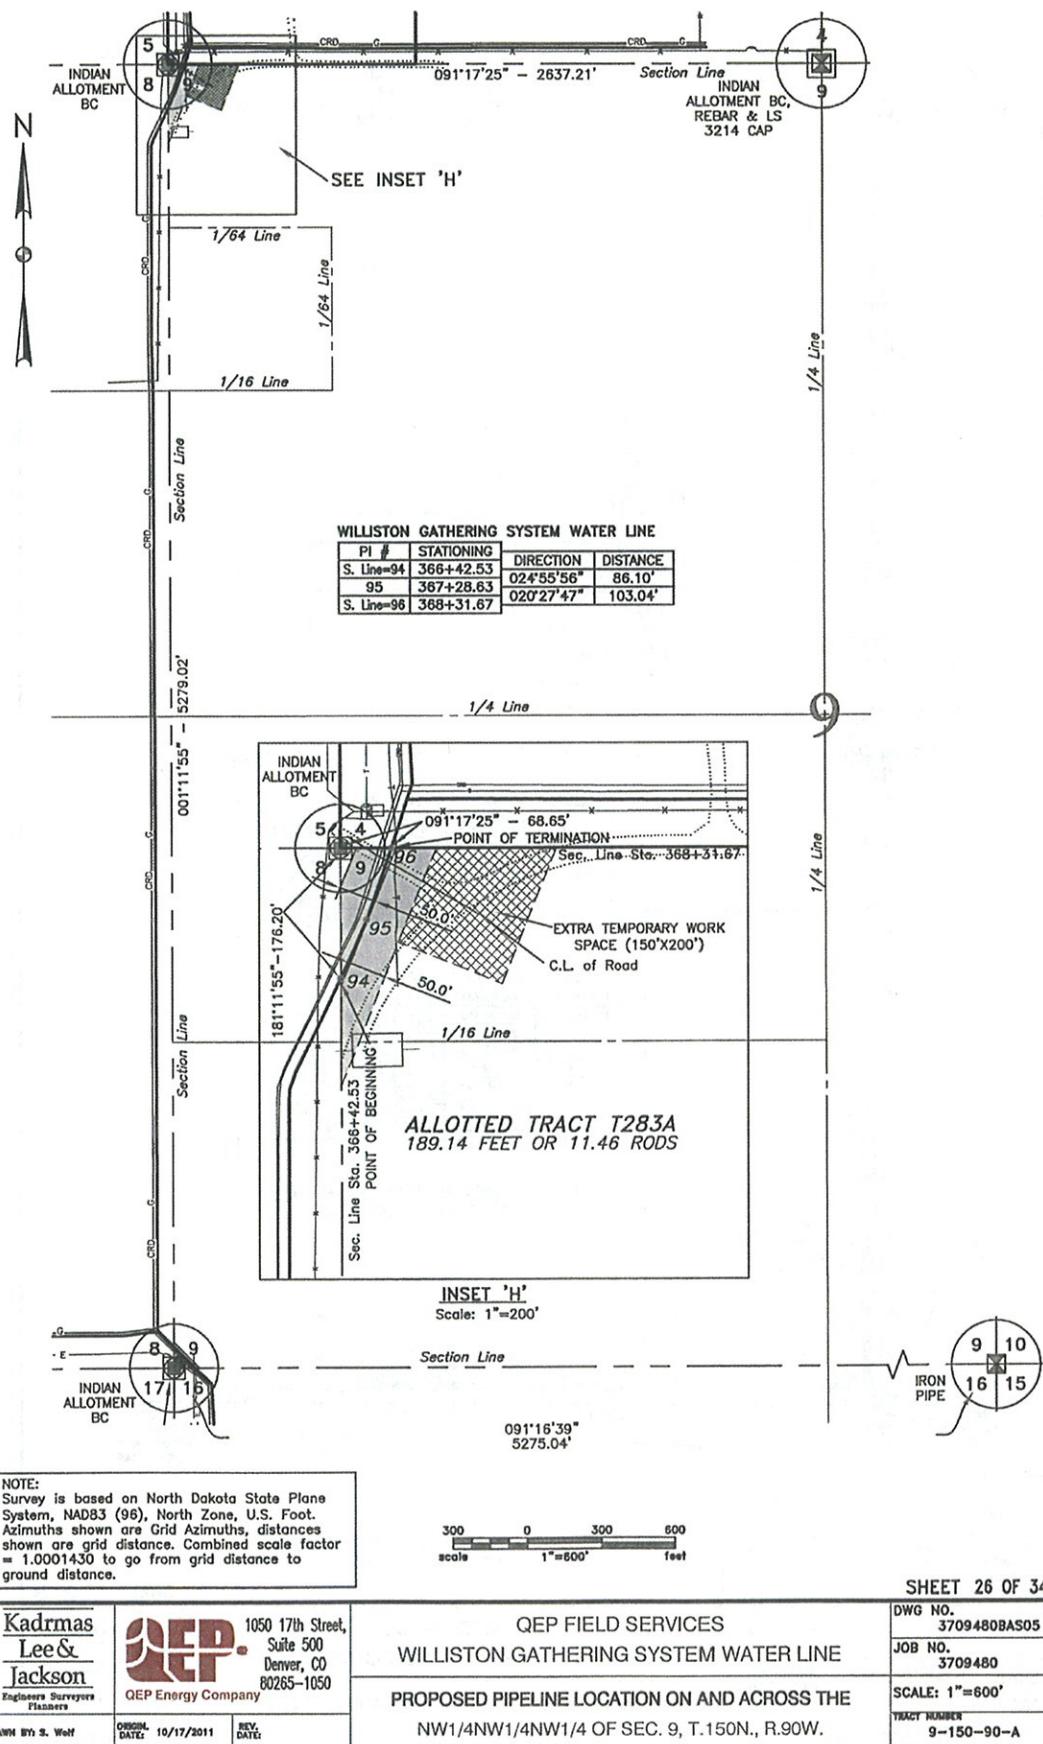

SHIRLEY and JAMES H. RUPPLE TRUSTEES
 SW1/4 OF SECTION 4, TOWNSHIP 150 NORTH, RANGE 90 WEST
 OF THE 5TH PRINCIPAL MERIDIAN, MCLEAN COUNTY, NORTH DAKOTA
 EXHIBIT "A"

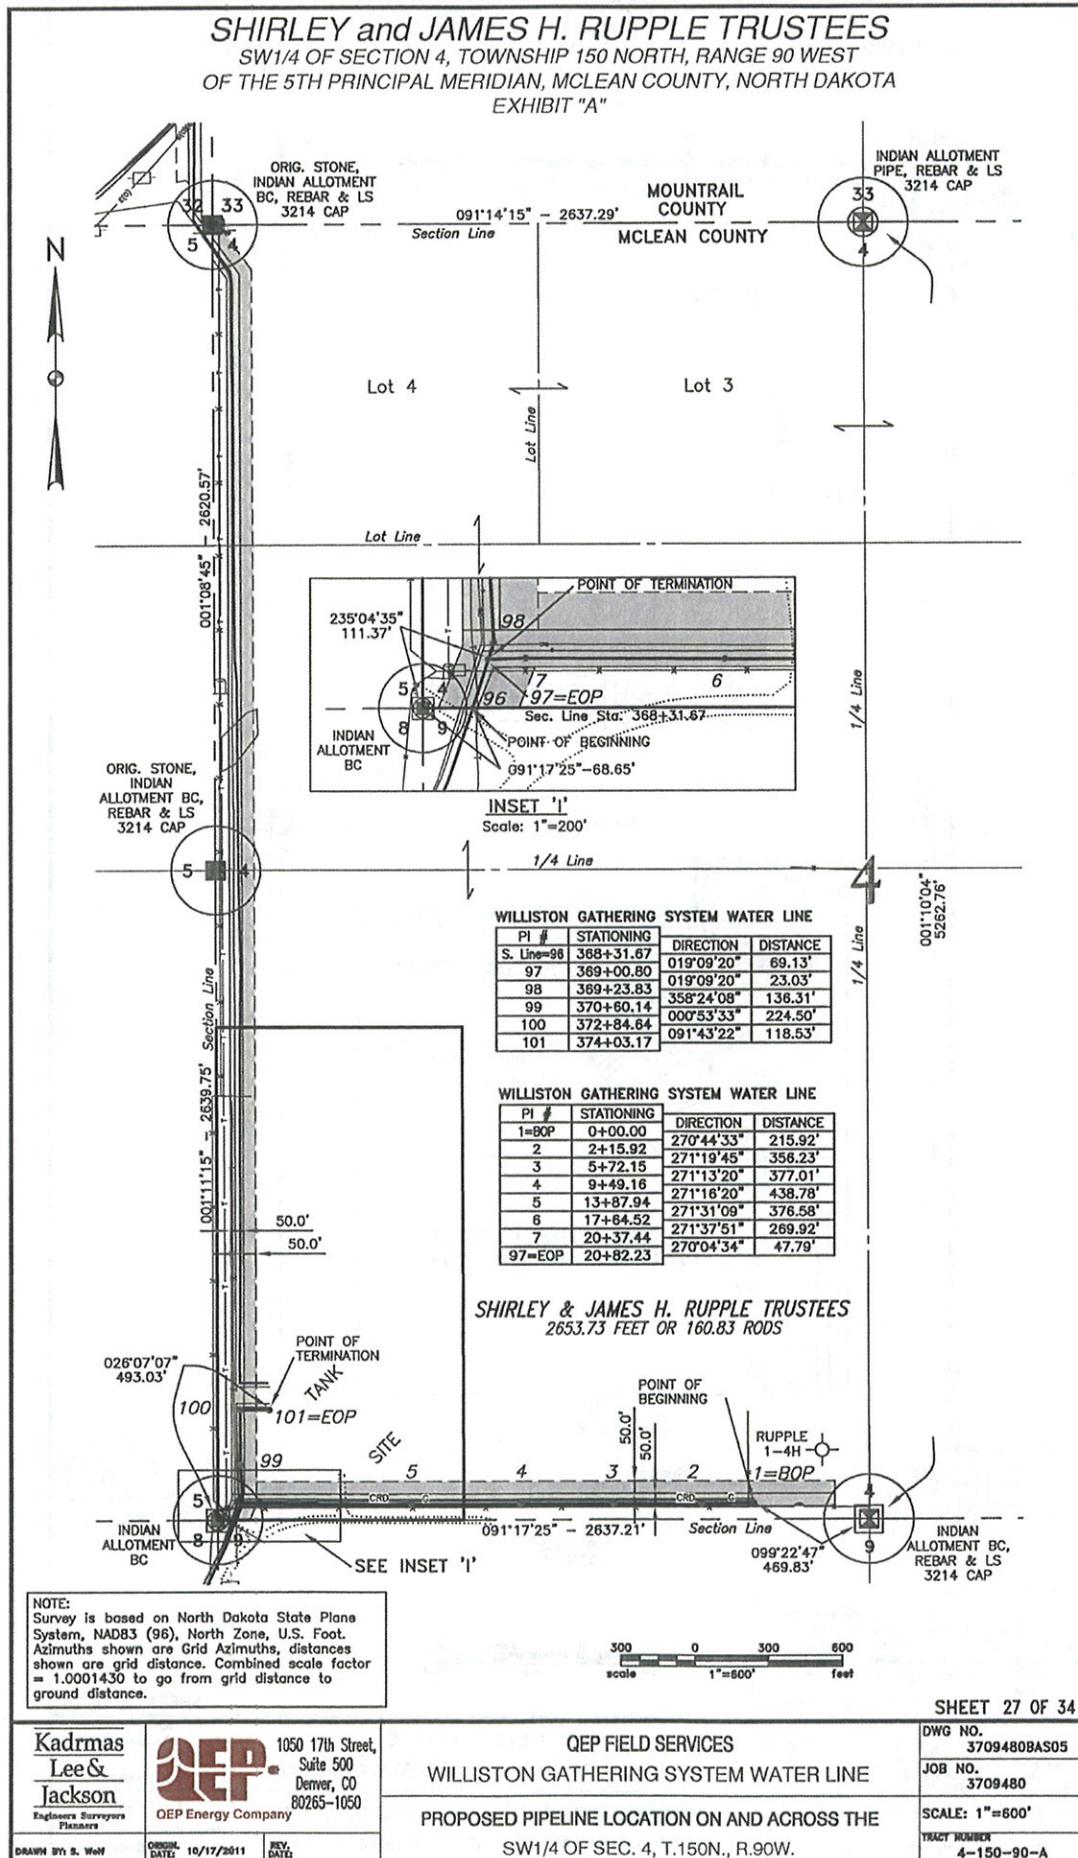

Kadrmas
 Lee &
 Jackson
 Engineers Surveyors
 Planners



1050 17th Street,
 Suite 500
 Denver, CO
 80265-1050

QEP FIELD SERVICES

WILLISTON GATHERING SYSTEM WATER LINE

DWG NO.
 3709480BAS05

JOB NO.
 3709480





SCALE: 1"=600'
 TRACT NUMBER
 4-150-90-A

PROPOSED PIPELINE LOCATION ON AND ACROSS THE
 SW1/4 OF SEC. 4, T.150N., R.90W.

THREE AFFILIATED TRIBES

SE1/4 OF SECTION 32, TOWNSHIP 150 NORTH, RANGE 90 WEST
OF THE 5TH PRINCIPAL MERIDIAN MCLEAN COUNTY, NORTH DAKOTA

EXHIBIT "A"

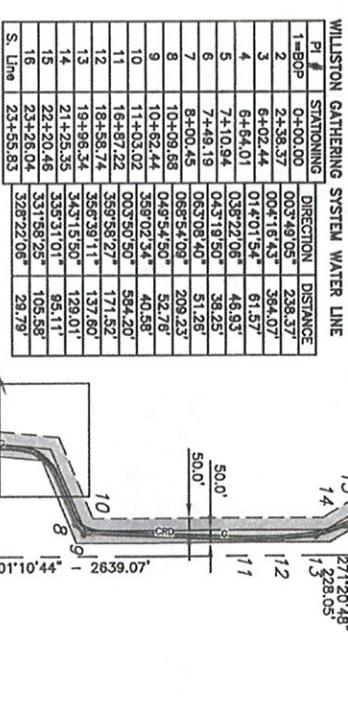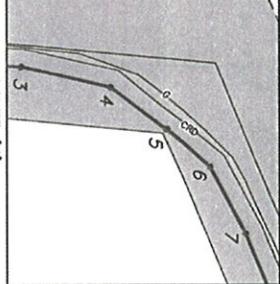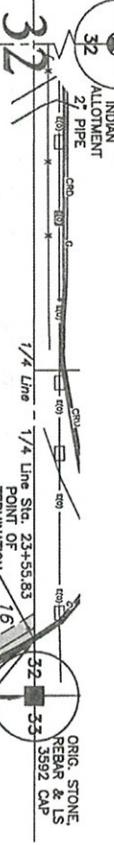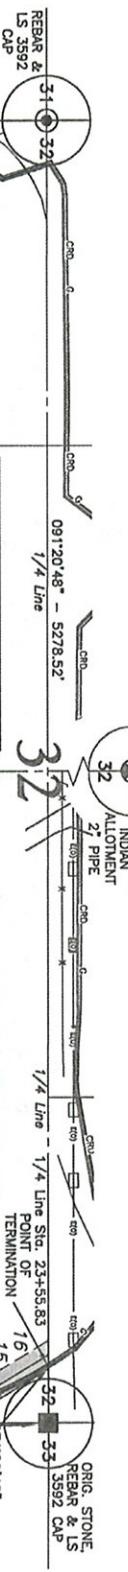

ALLOTTED TRACT 7357A 2355.83 FEET OR 142.78 RODS

POINT OF BEGINNING

MHA

1-32-31h


3185817"

686.13'

INDIAN ALLOTTED
TRACT PIPE
REAR & LS
349 CAP

NOTE:
Survey is based on North Dakota State Plane
System, NAD83 (96), North Zone, U.S. Feet.
Azimuths shown are Grid Azimuths, distances
shown are grid distance. Combined scale factor
1.001430 to go from grid distance to
ground distance.

300
scale
1"=100'
feet

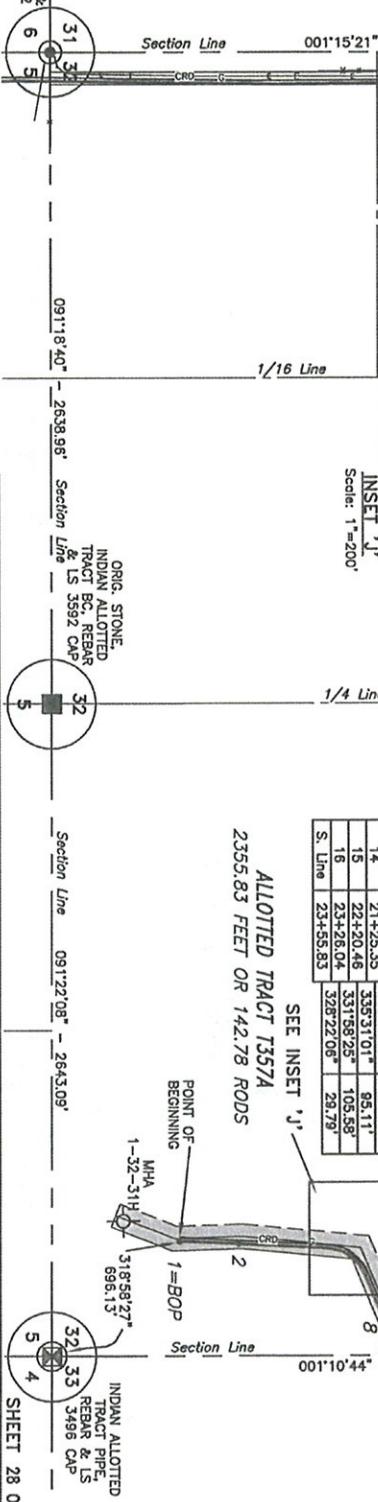

WILLISTON GATHERING SYSTEM WATER LINE 2355.83 FEET OR 142.78 RODS

POINT OF BEGINNING

MHA

1-32-31h

3185817"

686.13'

INDIAN ALLOTTED
TRACT PIPE
REAR & LS
349 CAP

SEE INSET 'J'

2355.83
FEET OR 142.78
RODS

SHEET 28 OF 34

2355.83
FEET OR 142.78
RODS

SHEET 28 OF 34

KadriMas Lee & Jackson	1000 17th Street, Suite 500 Bismarck, ND 80255-1050	QEP FIELD SERVICES WILLISTON GATHERING SYSTEM WATER LINE PROPOSED PIPELINE LOCATION ON AND ACROSS THE SE1/4 OF SEC. 32, T.150N., R.90W.
Dawn M. West	DATE: 10/7/2011 DWG. NO.: 3709480BAS05 JOB NO.: 3709480 SCALE: 1"=500' TRACT NUMBER: 32-150-90-F	LAYOUT: SE-32-150-90-F

THREE AFFILIATED TRIBES

E1/2NE1/4 OF SECTION 32, TOWNSHIP 150 NORTH, RANGE 90 WEST
OF THE 5TH PRINCIPAL MERIDIAN, MCLEAN COUNTY, NORTH DAKOTA


EXHIBIT "A"



ALLOTTED TRACT 354A

516.19 FEET OR 31.28 RODS

WILLISTON GATHERING SYSTEM WATER LINE	
P.I. #	STATIONING
P.I. #	STATIONING
S. Line	DIRECTION
17	23+55.83
	32B+22.05°
	135.78'
44=EOP	24+91.81
	3114.338°
	380.41'
28+72.02	

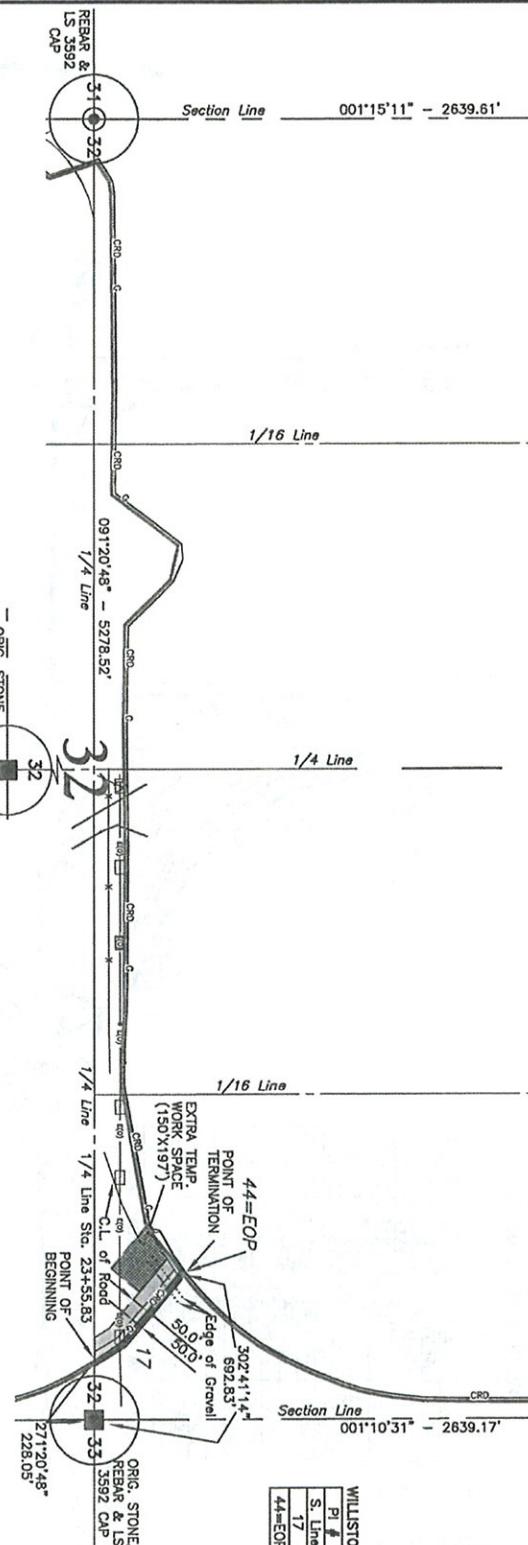

NOTE: Survey is based on North Dakota State Plane System, NAD83 (96), North Zone, U.S. Feet.

Azimuths shown are Grid Azimuths, distances shown are grid distances. Combined scale factor = 1.0001430 to go from grid distance to ground distance.

ALLOTTED TRACT 242A

E 1/2 OF LOT 4, E 1/2 SW 1/4 & SE 1/4 OF SECTION 18, TOWNSHIP 150 NORTH, RANGE 90 WEST
OF THE 5TH PRINCIPAL MERIDIAN, MCLEAN COUNTY, NORTH DAKOTA


EXHIBIT "A"

09112154*
5202.99*

3287.52*

27112154*
3287.52*


INDIAN ALLOTTED
TRACT BC

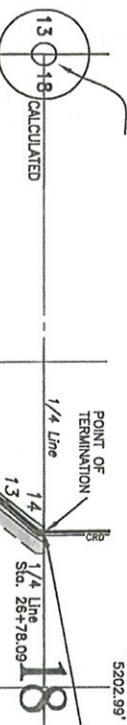

WILLISTON GATHERING SYSTEM WATER LINE

PI #	STATIONING	DIRECTION	DISTANCE
1-BOP	0+00.00	077°20'38"	112.25
2	1+12.25	017°04'48"	47.32
3	1+59.57	003°35'30"	70.46
4	2+50.03	353°58'06"	205.62
5	4+35.45	358°05'48"	79.55
6	5+15.00	004°20'46"	63.41
7	5+78.41	007°13'34"	145.95
8	7+24.36	007°45'49"	232.15
9	9+58.52	0071132"	668.15
10	10+22.87	00073825"	314.52
11	10+37.19	359°38'27"	202.42
12	21+38.61	040°45'40"	345.71
13	24+85.32	042°16'33"	178.20
14	26+63.32	00073255"	145.77
	26+78.09		

ALLOTTED TRACT 242A
2678.09 FEET OR 162.31 RODS

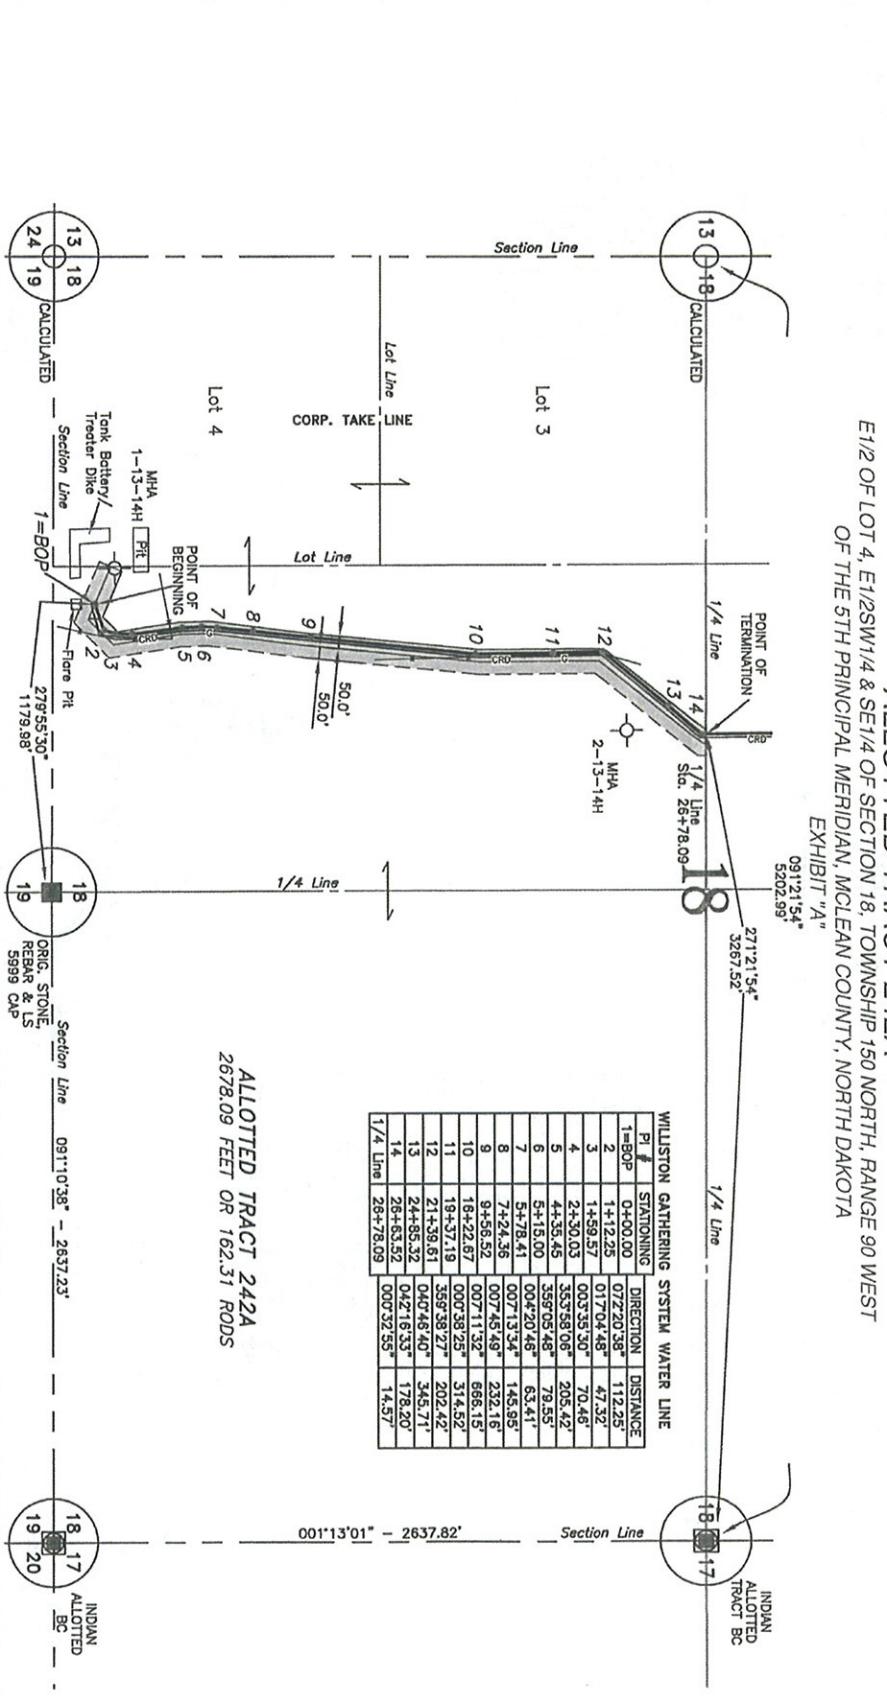

SHEET 30 OF 34

LAYOUT: ED74-SC-18-190-90

NOTE: Survey is based on North Dakota State Plane System, NAD83 (96), North Zone, U.S. Feet.


Azimuths shown are Grid Azimuths, distances shown are grid distance. Combined scale factor = 1.001430 to go from grid distance to ground distance.

© Kadomas Lee & Jackson 2011

REUBEN OLSON

E1/2NW1/4 & NE1/4 OF SECTION 18, TOWNSHIP 150 NORTH, RANGE 90 WEST
OF THE 5TH PRINCIPAL MERIDIAN, MCLEAN COUNTY, NORTH DAKOTA

EXHIBIT "A"

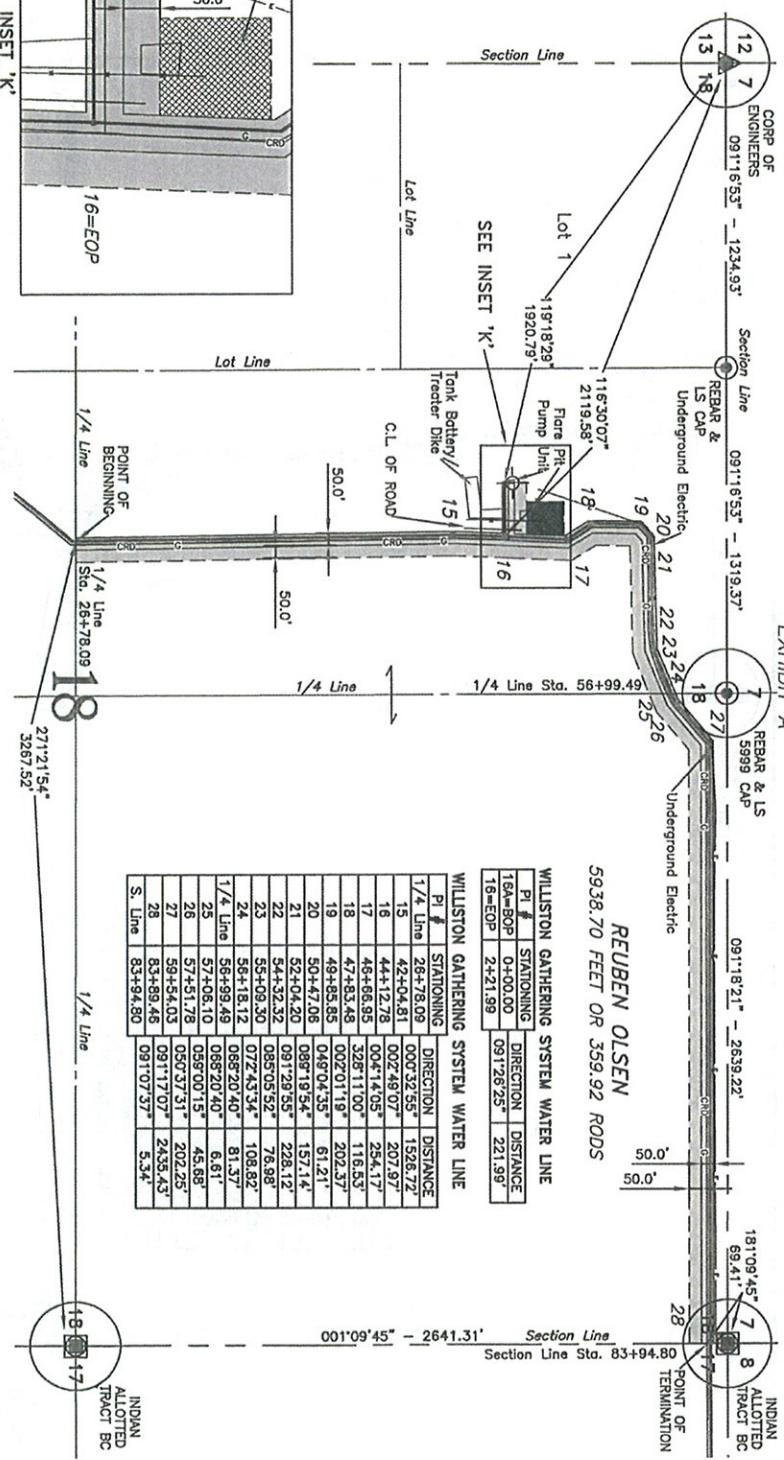

NOTE: Survey is based on North Dakota State Plane System, NAD83 (95), North Zone, U.S. Feet. All dimensions shown are grid distances. Combined scale factor = 1.0001-3.0 to go from grid distance to ground distance.

300
0
300
600
Scale: 1"=600'
feet

SHEET 31 OF 34


Kadmas Lee & Jackson Kadmas Lee & Jackson Surveyors	1050 17th Street, Suite 500 Denver, CO 80265-1050	QEP FIELD SERVICES
WILLISTON GATHERING SYSTEM WATER LINE		
DWG NO. JOB NO. DATE	079480BAS05 3709480 10/17/2011	PROPOSED PIPELINE LOCATION ON AND ACROSS THE E1/2NW1/4 & NE1/4 OF SEC. 18, T. 150N., R. 90W.

LAYOUT: DIM-NL 18-15-00

ALLOTTED TRACT 361A


NW $\frac{1}{4}$ OF SECTION 17, TOWNSHIP 150 NORTH, RANGE 90 WEST
OF THE 5TH PRINCIPAL MERIDIAN, MCLEAN COUNTY, NORTH DAKOTA

EXHIBIT "A"

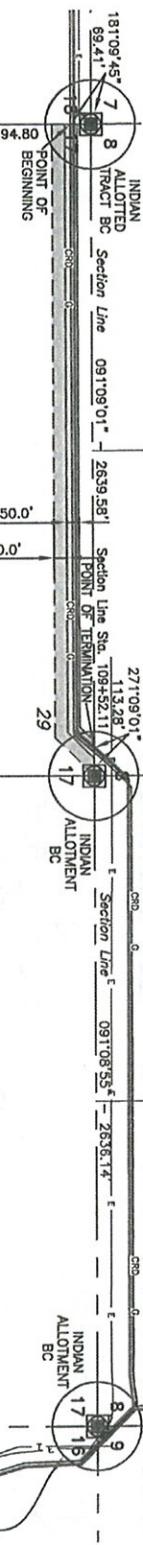

ALLOTTED TRACT 361A 255.73 FEET OR 154.99 RODS

WILLISTON GATHERING SYSTEM WATER LINE		
PI #	STATIONING	DIRECTION
S. Line	83+94.80	081°07'37" 2468.36
29	108+51.16	042°23'09" 90.95'
S. Line	109+52.11	

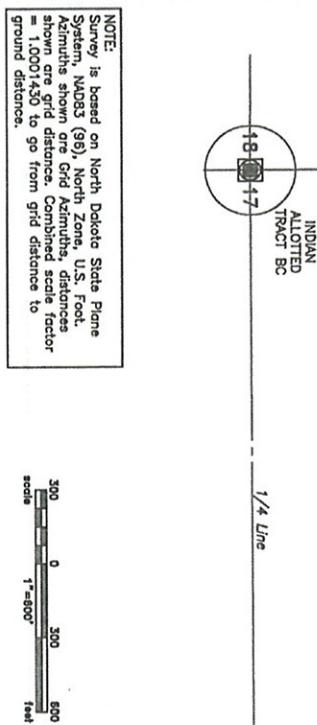


Kadomas Lee & Jackson Engineers Planners Surveyors	1050 17th Street, Suite 500 Denver, CO 80205-1050	QEP FIELD SERVICES
WILLISTON GATHERING SYSTEM WATER LINE		
PROPOSED PIPELINE LOCATION ON AND ACROSS THE		
NW $\frac{1}{4}$ OF SEC. 17, T.150N., R.90W.		
DOWN R. S. W.E.F.	ORIGIN DATE: 10/17/2011	REV. DATE:
SCALE: 1"=600' TOLERANCE 17-150-90-C		

THREE AFFILIATED TRIBES

E1/2SW1/4 & W1/2SE1/4 OF SECTION 8, TOWNSHIP 150 NORTH, RANGE 90 WEST
OF THE 5TH PRINCIPAL MERIDIAN, MCLEAN COUNTY, NORTH DAKOTA

EXHIBIT "A"

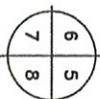

1/4 Line

8

1/4 Line

17

N

ALLOTTED TRACT T201A 491.92 FEET OR 90.42 RODS

WILLISTON GATHERING SYSTEM WATER LINE			
PL #	STATIONING	DIRECTION	DISTANCE
S. Line	109+52.11	042°23'09"	109.44'
30	110+61.55	045°35'38"	58.67'
1/4 Line	111+40.22	045°35'38"	18.85'
31	111+39.07	061°15'50"	1304.96'
1/16 Line	124+44.03		

001'11'55"
5279.02'

Section Line

Section Line


Section Line

1/16 Line

1/16 Line

1/4 Line

1/16 Line

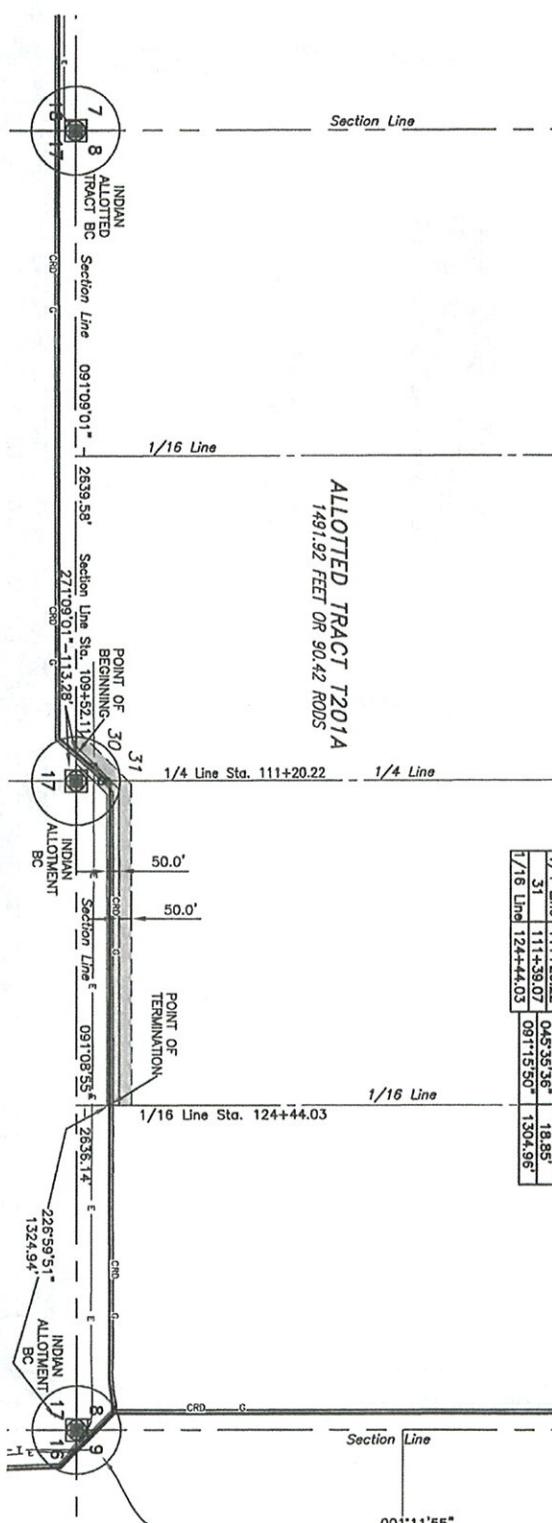

SHEET 33 OF 34

NOTE:
Survey is based on North Dakota State Plane
System, NAD83 (93), North Zone, U.S. Feet
Azimuths shown are Grid Azimuths; distances
shown are grid distances. Combined scale factor
= 1.0001430 to go from grid distance to
ground distance.

300 0 300 600
scale 1:500' feet


LAYOUT: ESP -WES- B-150-90-D

Kadamus	1050 17th Street, Suite 500 Denver, CO 80265-1050	QEP FIELD SERVICES
Lee & Jackson	Regulatory Services Planners	WILLISTON GATHERING SYSTEM WATER LINE
QEP Energy Company	QEP Energy Company	PROPOSED PIPELINE LOCATION ON AND ACROSS THE
Drawn by: S. Web	Date: 10/17/2011	E1/2SW1/4 & W1/2SE1/4 OF SEC. 8, T. 150N., R. 90W.

ALLOTTED TRACT 1518

E1/2SE1/4 OF SECTION 8, TOWNSHIP 150 NORTH, RANGE 90 WEST
OF THE 5TH PRINCIPAL MERIDIAN, MCLEAN COUNTY, NORTH DAKOTA

EXHIBIT "A"

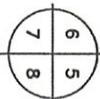

WILLISTON GATHERING SYSTEM WATER LINE			
PI #	STATIONING	DIRECTION	DISTANCE
1/16 Line	124+44.03	091°15'50"	22.22'
32	124+46.25	091°13'00"	1985.21'
33	135+51.46	083°38'58"	95.30'
34	135+56.75	0900111°	45.69'
87=EOP	137+02.45		

ALLOTTED TRACT 1518

1258.42 FEET OR 76.27 RODS

001°11'55"
5279.02'

1/16 Line

NOTE:
Survey is based on North Dakota State Plane
System, NAD83 (96), North Foot.
Azimuths shown are Grid Azimuths, distances
shown are grid distances. Combined scale factor
= 1.0001430 to go from grid distance to
ground distance.

300
0
300
feet

scale
1'=600'

300
0
300
feet

scale
1'=600'

SHEET 34 OF 34

DWG NO.
3709480BASD5

JOB NO.
3709480

Kadmas
Lee &
Jackson
QEP
Energy Company
1050 17th Street,
Suite 500
Denver, CO
80265-1050
PROPOSED PIPELINE LOCATION ON AND ACROSS THE
E1/2SE1/4 OF SEC. 8, T. 150N., R. 90W.

SCALE: 1'=600'
TARGET NUMBER
8-150-90-C

